
KOLB LAND CONSULTING, INC.

LAND SURVEYING . SUBDIVIDING . LAND PLANNING

929 WILLIAMS STREET

LAKE GENEVA, WISCONSIN 53147

414-248-3697

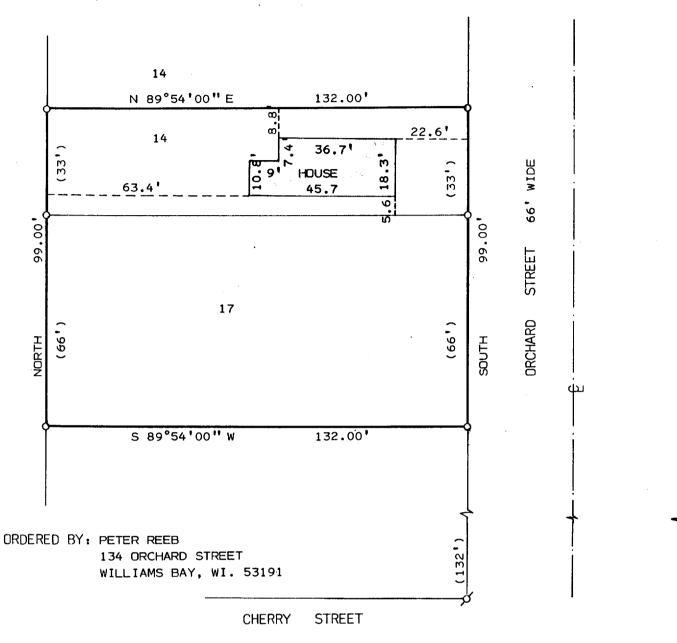

PLAT OF SURVEY OF

NOTE: THE WEST STREET LINE OF ORCHARD STREET ASSUMED DUE NORTH-SOUTH. THE SOUTH 1/2 OF LOT 14 AND LOT 17 OF LOCKWOOD'S ADDITION A SUBDIVISION LOCATED IN THE VILLAGE OF WILLIAMS BAY, WALWORTH COUNTY, WISCONSIN.



SCALE: 1" = 30'
LEGEND

Ø - IRON PIPE FOUND

O - IRON PIPE SET

(66') - AS RECORDED

I, HAROLD H. KOLB, DO HEREBY CERTIFY
HAT I HAVE SURVEYED THE PROPERTY
HEREON DESCRIBED ACCORDING TO THE
OFFICIAL RECORDS AND THAT THE PLAT
HEREON IS A CORRECT REPRESENTATION
OF THE LOT LINES AND THE PRINCIPAL
LINES OF THE BUILDING, TO THE BEST
OF MY KNOWLEDGE AND BELIEF.
SURVEY NOT VALID UNLESS SURVEYOR'S SIGNATURE
IS IN RED.

HAR	OLD	н.	KOL	В.

WISCONSIN REGISTERED LAND SURVEYOR, S-187

WMB-70

DATE FEBRUARY 23, 1994

REVISED_

REVISED _____

MCM - 17 MCM - 17

11-1065