


SPRING ST.

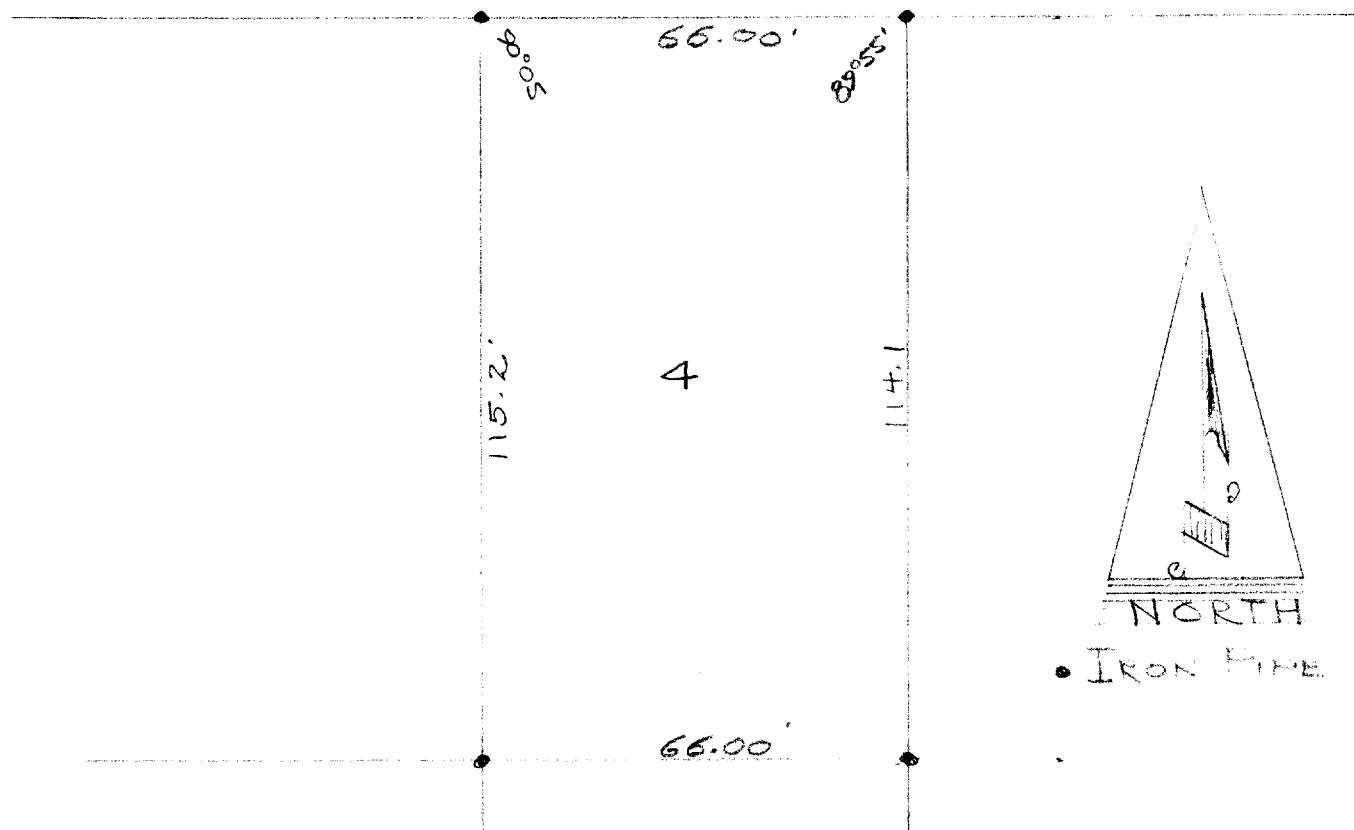

**DESCRIPTION:**

Lot 4, Johnson's Addition to the Village of Williams Bay, Walworth County, Wisconsin.

**CERTIFICATE:**

I, James F. Biagi, Surveyor do hereby certify that I have surveyed the property hereon described.

Dated August 7th 1964.

*James F. Biagi*  
 James F. Biagi, RLS 272  
 Elkhorn, Wisconsin.

