
ABERNATHY and ASSOCIATES Kenneth B. Abernathy Jr. Wisconsin Registered Land Surveyor S-1594

W4056 Bray Road Elkhorn, Wisconsin 53121 Phone: (414) 723-4260 (office) (414) 723-4813 (residence)

PLAT OF SURVEY





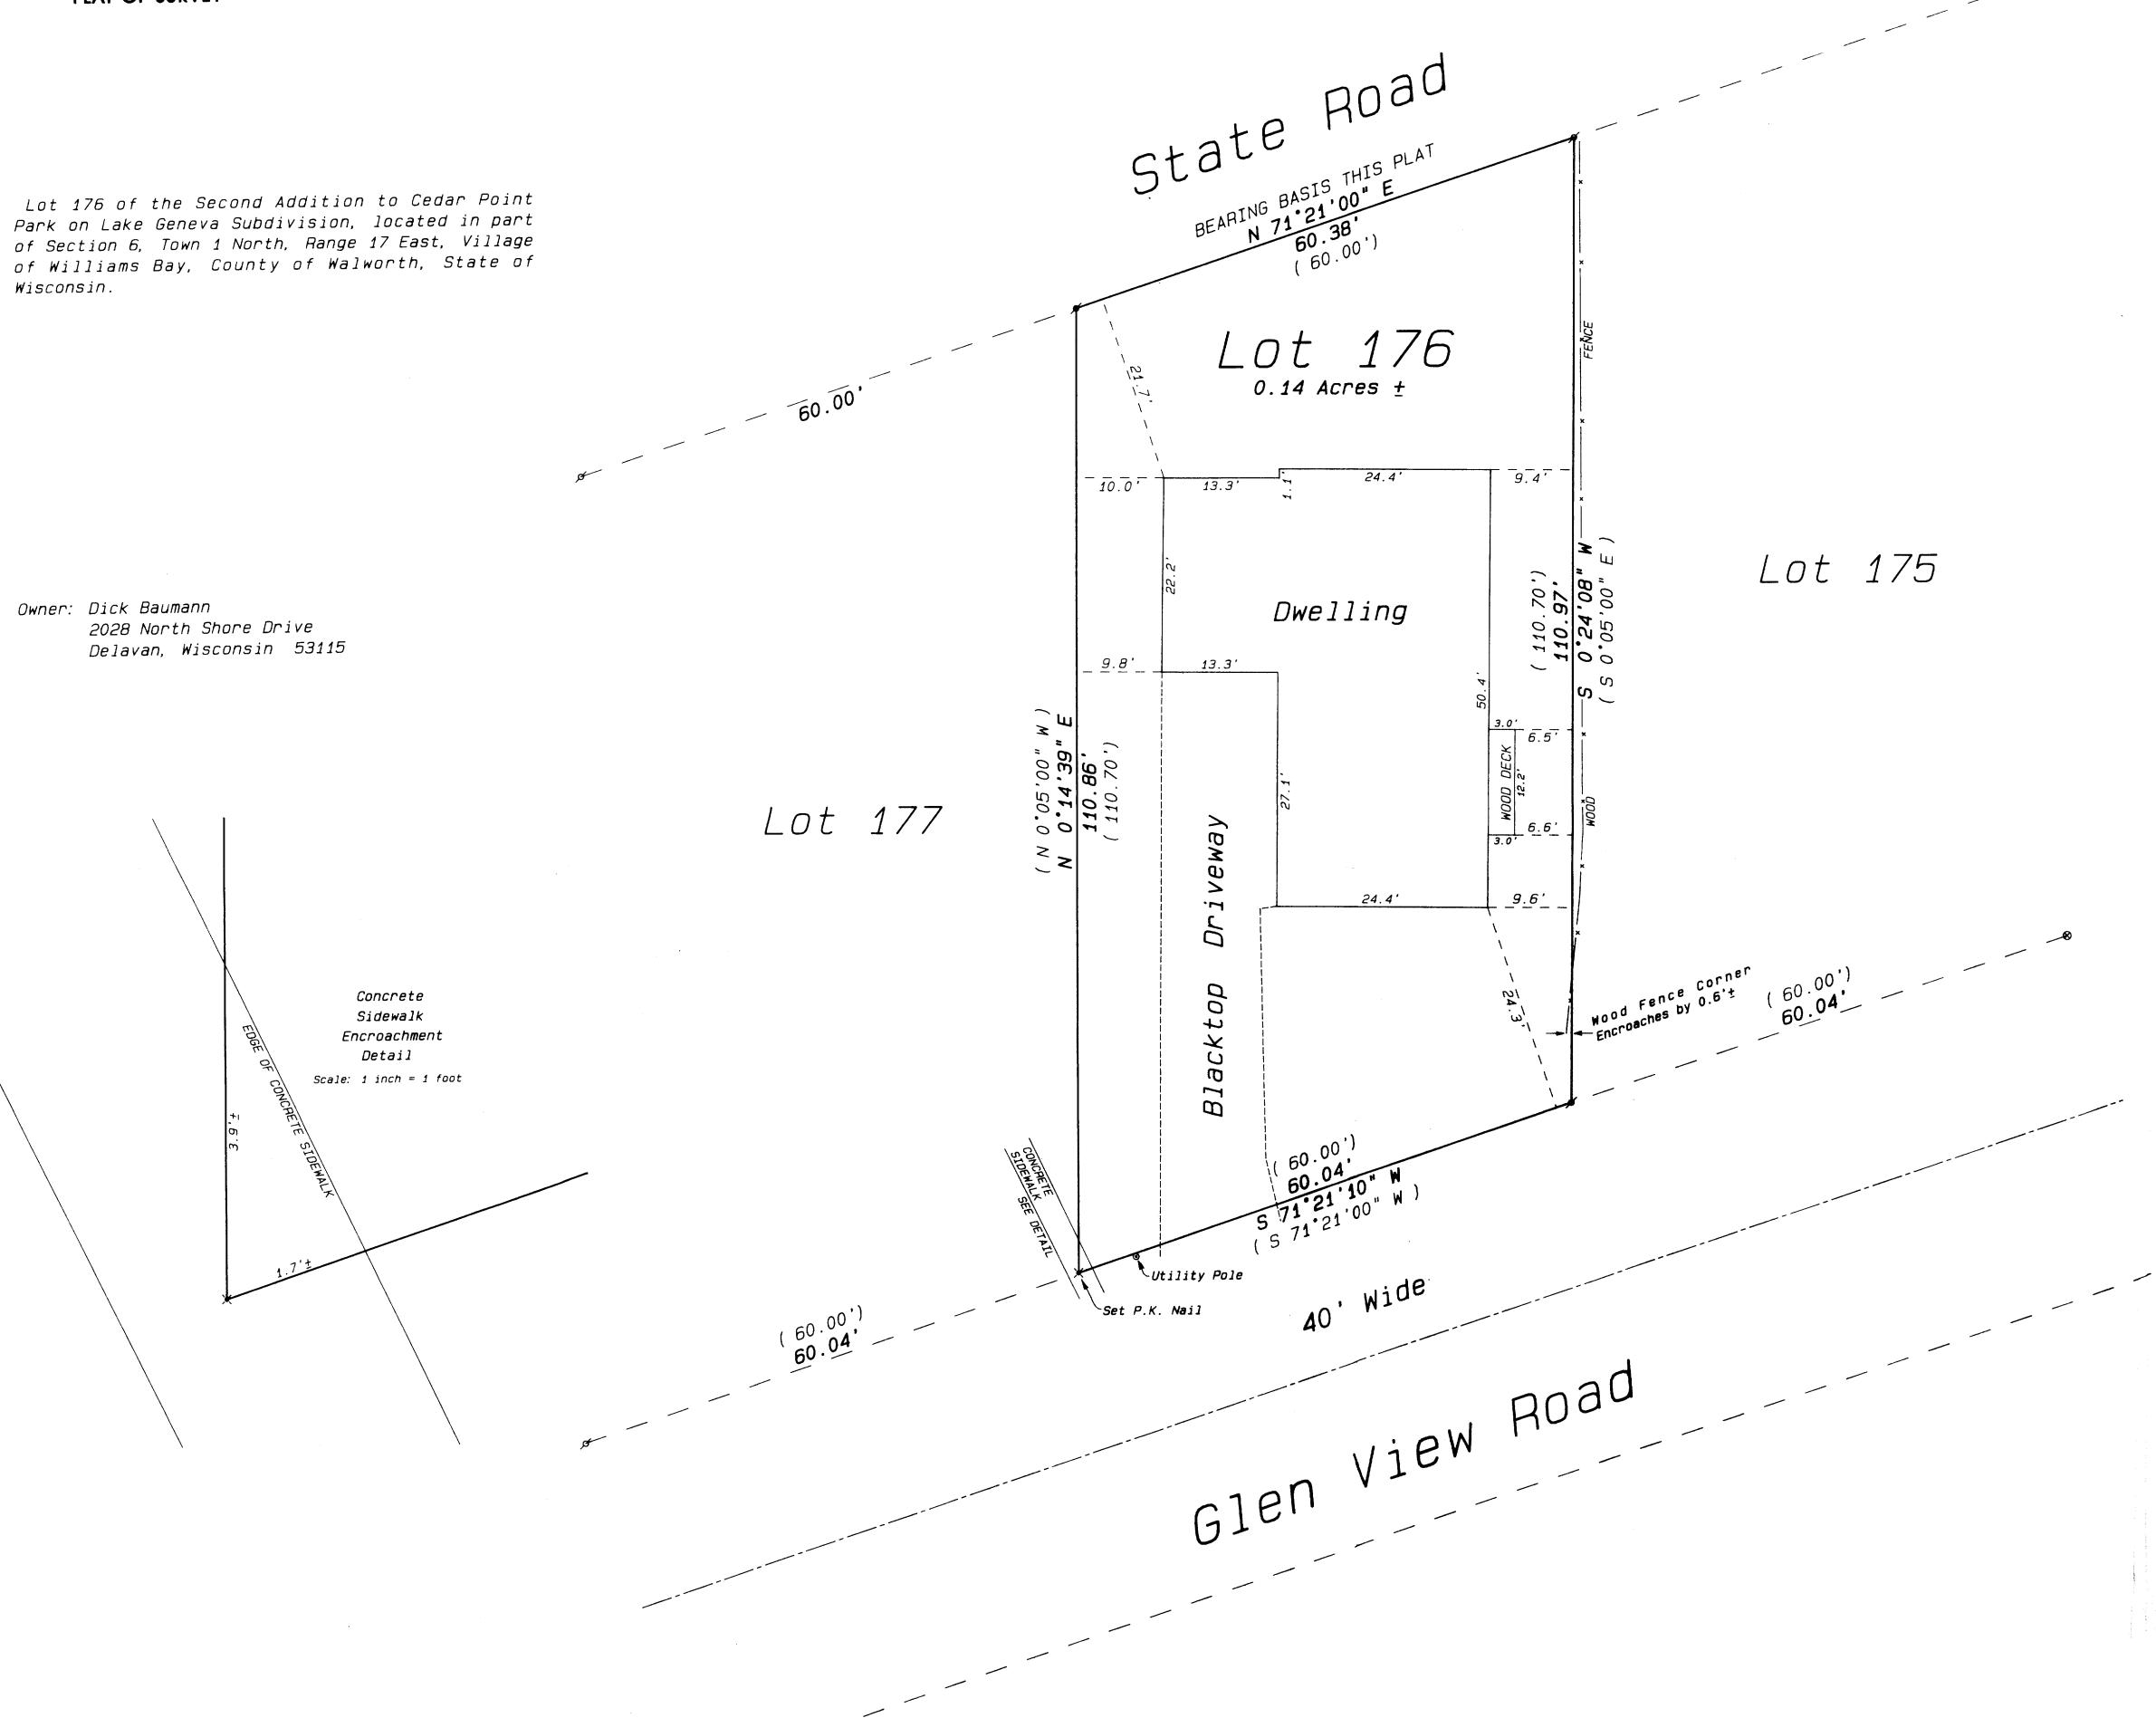

- FOUND INON PIPE
- FOUND IRON ROD FOUND BRASS CAPPED MONUMENT
- FOUND CONCRETE MONUMENT + CHISEL CUT IN CONCRETE
- SET IRON ROD, 24" LONG, WEIGHING
 1.5 LBS./LINEAL FT., 3/4" DIA.
- SET IRON ROD, 30" LONG, WEIGHING 4.5 LBS./LINEAL FT., 1-11/16" DIA.
- (XX) RECORDED AS DIMENSION

-x-x- EXISTING FENCE

SCALE: 1"= 10 FEET



"I hereby certify that the above described property has been surveyed by me or under my direction and that the above map is a true representation thereof and shows the size and location of the property. its exterior boundaries, the location of all visible structures and dimensions of all principal buildings thereon, boundary fences, apparent easements, roadways and visible encroachments, if any."

"This survey is made for the use of the present owners of the property, and also those who purchase, mortgage, or guarantee the title thereto.

KENNETH B. ABERNATHY, JR. WISCONSIN REGISTERED LAND SURVEYOR,

£ NC63-188

Date: October 27, 1995 Job No.