


**BAYWOOD HEIGHTS  
ADDITION NO. 2**  
Village of Williams Bay  
Walworth County, Wisconsin

**PLAT OF SURVEY  
of  
LOT 104**  
No. 440 FROST DRIVE


**FARRIS, HANSEN & ASSOCIATES, INC.**  
Engineering, Architecture, Surveying  
7 Ridgway Court P.O. Box 437  
ELKHORN, WISCONSIN 53121  
Office: (414) 723-2098  
Fax: (414) 723-5886

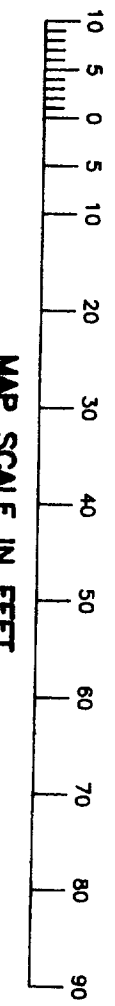

MAP SCALE IN FEET

**MAP LEGEND**

- IRON PIPE STAKE FOUND - 1" DIA.
- IRON PIPE STAKE FOUND - 1.5" DIA.
- IRON PIPE STAKE FOUND - 2" DIA.
- IRON REBAR STAKE FOUND - 0.75" DIA.
- CONCRETE MONUMENT FOUND - 6" DIA.
- IRON REBAR STAKE SET - 1.2" DIA X 30" X 4.3 LB/FT
- IRON REBAR STAKE SET - 0.75" DIA X 24" X 1.3 LB/FT

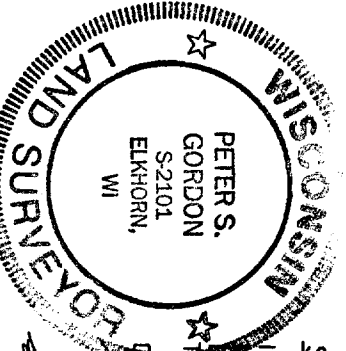

**LEGAL DESCRIPTION OF LAND SURVEYED:**  
LOT 104 OF BAYWOOD HEIGHTS ADDITION NO. 2 IN THE VILLAGE OF WILLIAMS BAY, WALWORTH COUNTY, WISCONSIN ACCORDING TO THE PLAT THEREOF RECORDED WITH THE WALWORTH COUNTY REGISTER OF DEEDS IN CABINET B OF PLATS ON SLIDE 97 AS DOCUMENT NO. 197248.

**SURVEYOR'S CERTIFICATE**

I HEREBY CERTIFY THAT THE PROPERTY DESCRIBED HEREON HAS BEEN SURVEYED UNDER MY DIRECTION AND THAT THIS MAP IS A TRUE REPRESENTATION THEREOF AND SHOWS THE SIZE AND LOCATION OF THE PROPERTY AND ITS EXTERIOR BOUNDARY LINES AND MONUMENTS. THIS SURVEY IS MADE FOR THE USE OF THE PRESENT OWNERS OF THE PROPERTY AND ALSO THOSE WHO PURCHASE, MORTGAGE, OR GUARANTEE THE TITLE THERETO WITHIN ONE YEAR FROM THE DATE HEREOF.

DATED THIS 15th DAY OF MARCH 1997  
REVISED 5-20-97 TO SHOW ROAD REVISIONS  
REVISED 5-10-97 TO SHOW AS-BUILT FOUNDATION  
SURVEYOR: *Peter S. Gordon* 5-21-01  
REGISTRATION

WORK ORDERED BY: *GENEVA HOMES* DATE: 3-14-97

NOTE: COPIES OF THIS MAP TO WHICH THE ABOVE CERTIFICATE WILL APPLY ARE BLUE LINE PRINTS SHOWING THE SURVEYOR'S ORIGINAL SEAL AND SIGNATURE IN BLACK INK. COPIES BY ANY OTHER MEANS MAY SHOW ALTERATIONS WHICH DO NOT REPRESENT THE SURVEYOR'S WORK PRODUCT.

PROJECT NO. 3228  
DATE 3-18-97  
SHEET NO. 1 of 1

REVISIONS