
N



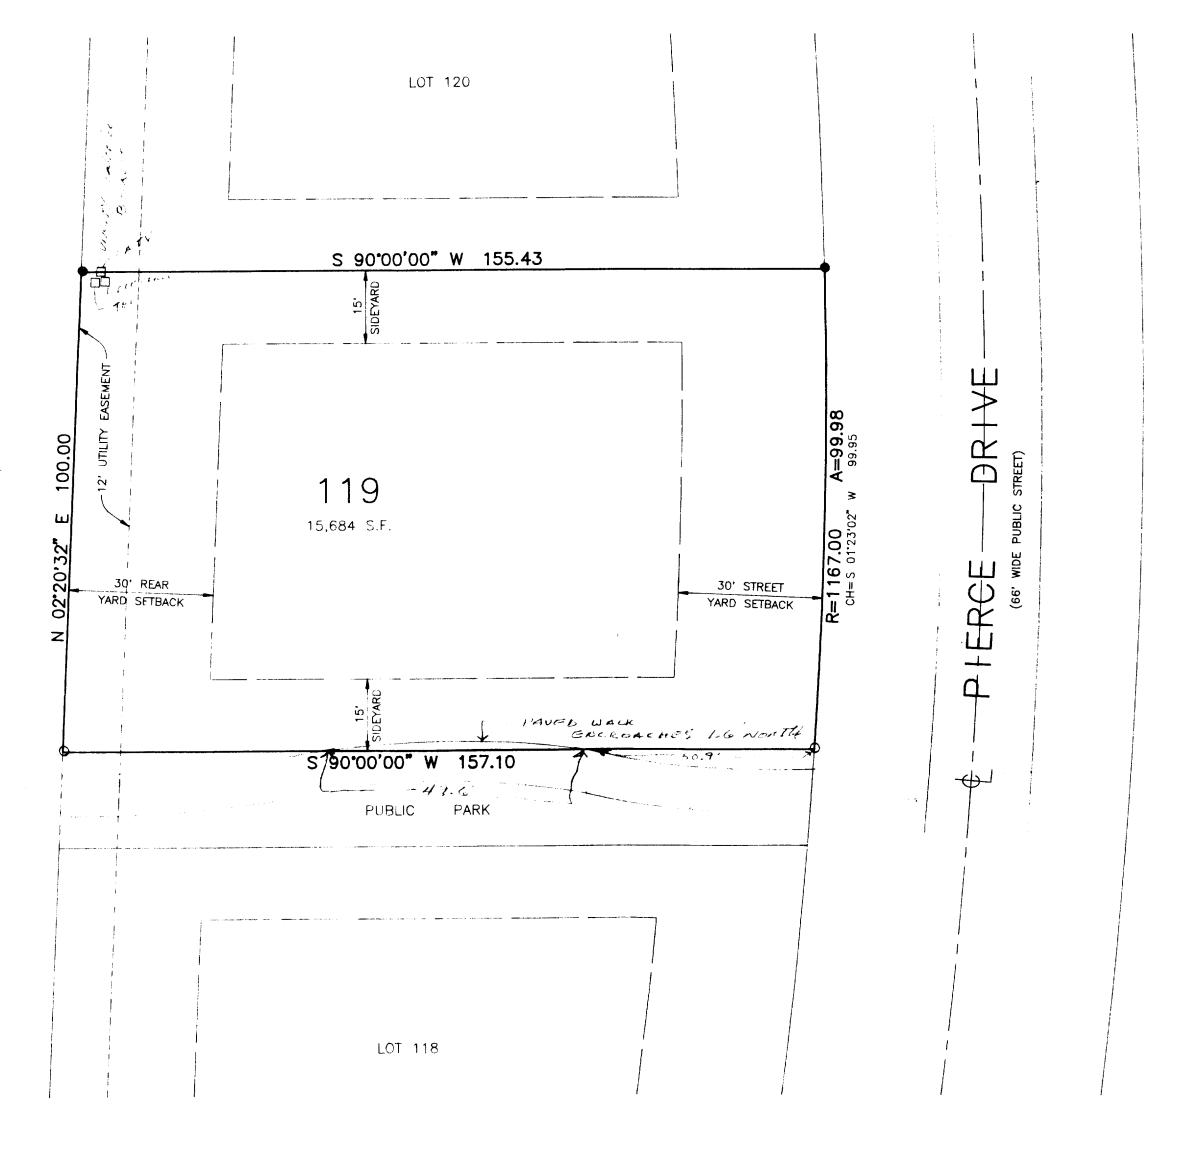

10 5 0 5 10

MAP SCALE IN FEET

WORK ORDERED BY: PAT May 6 DATE: 2-25-98

MAP LEGEND

X = IRON PIPE STAKE FOUND - 1" DIA. =IRON PIPE STAKE FOUND - 1.5" DIA. ⊗ =IRON PIPE STAKE FOUND - 2" DIA.

● =IRON REBAR STAKE FOUND - 0.75" DIA. \bigcirc =CONCRETE MONUMENT FOUND - 6" DIA. O = IRON REBAR STAKE SET -1.2" DIA X 30" X 4.3 LB/FT ALL OTHER LOT CORNERS = IRON REBAR STAKE SET -0.75" DIA. X 24" X 1.3 LB/FT SCONSIN PETER S. GORDON S-2101 ELKHORN,

LEGAL DESCRIPTION OF LAND SURVEYED:

LOT 119 OF BAYWOOD HEIGHTS ADDITION NO. 2 IN THE VILLAGE OF WILLIAMS BAY, WALWORTH COUNTY, WISCONSIN ACCORDING TO THE PLAT THEREOF RECORDED WITH THE WALWORTH COUNTY REGISTER OF DEEDS IN CABINET B OF PLATS ON SLIDE 97 AS DOCUMENT NO. 197248.

SURVEYOR'S CERTIFICATE

HEREBY CERTIFY THAT THE PROPERTY DESCRIBED HEREON HAS BEEN SURVEYED UNDER MY DIRECTION AND THAT THIS MAP A TRUE REPRESENTATION THEREOF AND SHOWS THE SIZE AND LOCATION OF THE PROPERTY AND ITS EXTERIOR BOUNDARY DISCUSSIONS AND MONUMENTS. THIS SURVEY IS MADE FOR THE USE OF THE PRESENT OWNERS OF THE PROPERTY, AND ALSO THESE WHO PURCHASE, MORTGAGE, OR GUARANTEE THE TITLE THERETO WITHIN ONE YEAR FROM THE DATE HEREOF.

DATED THIS 27th DAY OF FEBRUARY, 19

NOTE: COPIES OF THIS MAP TO WHICH THE ABOVE CERTIFICATE WILL APPLY ARE BLUE LINE PRINTS SHOWING THE SURVEYOR'S ORIGINAL SEAL AND SIGNATURE IN BLACK INK. COPIES BY ANY OTHER MEANS MAY SHOW ALTERATIONS WHICH DO NOT REPRESENT THE SURVEYOR'S WORK PRODUCT.

HEIGHTS BAYWOOD

NO. **ADDITION**

SURVE 352 PIERCE DRIVE Š.

Court P.O. Box 437
N, WISCONSIN 53121
(414) 723-2098
(414) 723-5886 ASSOCIATE Architecture, Ridgway C. ELKHORN, Office: (HANSEN neering, FARRIS, Engine

REVISIONS

PROJECT NO. 3228 DATE

Z-Z7-98 SHEET NO. of

MBW3-70