


ABELL
SURVEYING & MAPPING
1140 SEQUOIA STREET • DELAVAN, WISCONSIN 53115
414-728-6737

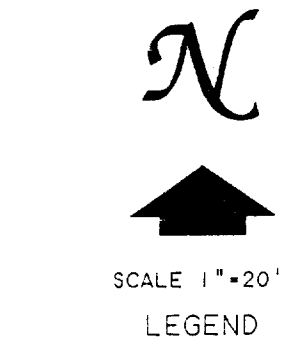

- - IRON PIPE FOUND
- - IRON ROD FOUND
- - IRON PIPE SET
- ✕ - WIRE FENCE
- WS - WOOD STOOP
- BE - BASEMENT ENTRY
- () - RECORDED AS

PLAT OF SURVEY OF
LOT 4, BLOCK 3, HARBOR VIEW, LOCATED IN
THE VILLAGE OF WILLIAMS BAY, WALWORTH
COUNTY, WISCONSIN.

I HEREBY CERTIFY THAT I HAVE SURVEYED THE ABOVE DESCRIBED PROPERTY AND THAT THE ABOVE MAP IS A TRUE REPRESENTATION THEREOF AND SHOWS THE SIZE AND LOCATION OF THE PROPERTY, ITS EXTERIOR BOUNDARIES, THE LOCATION OF ALL VISIBLE STRUCTURES AND DIMENSIONS OF ALL PRINCIPAL BUILDINGS THEREON, BOUNDARY FENCES, APPARENT EASEMENTS, ROADWAYS AND VISIBLE ENCROACHMENTS, IF ANY, TO THE BEST OF MY KNOWLEDGE AND BELIEF.


THIS SURVEY IS MADE FOR THE USE OF THE PRESENT OWNERS OF THE PROPERTY, AND ALSO THOSE WHO PURCHASE, MORTGAGE, OR GUARANTEE THE TITLE THERETO WITHIN ONE (1) YEAR FROM DATE HEREON.

Edward J. Nezworski
EDWARD J. NEZWORSKI
WISCONSIN REGISTERED LAND SURVEYOR, S-2139

July 31, 1998

DATE: JULY 31, 1998 JOB NUMBER - 98137
NOTE: THIS IS NOT A CERTIFIED COPY UNLESS SEALED.

MENOMINEE ROAD

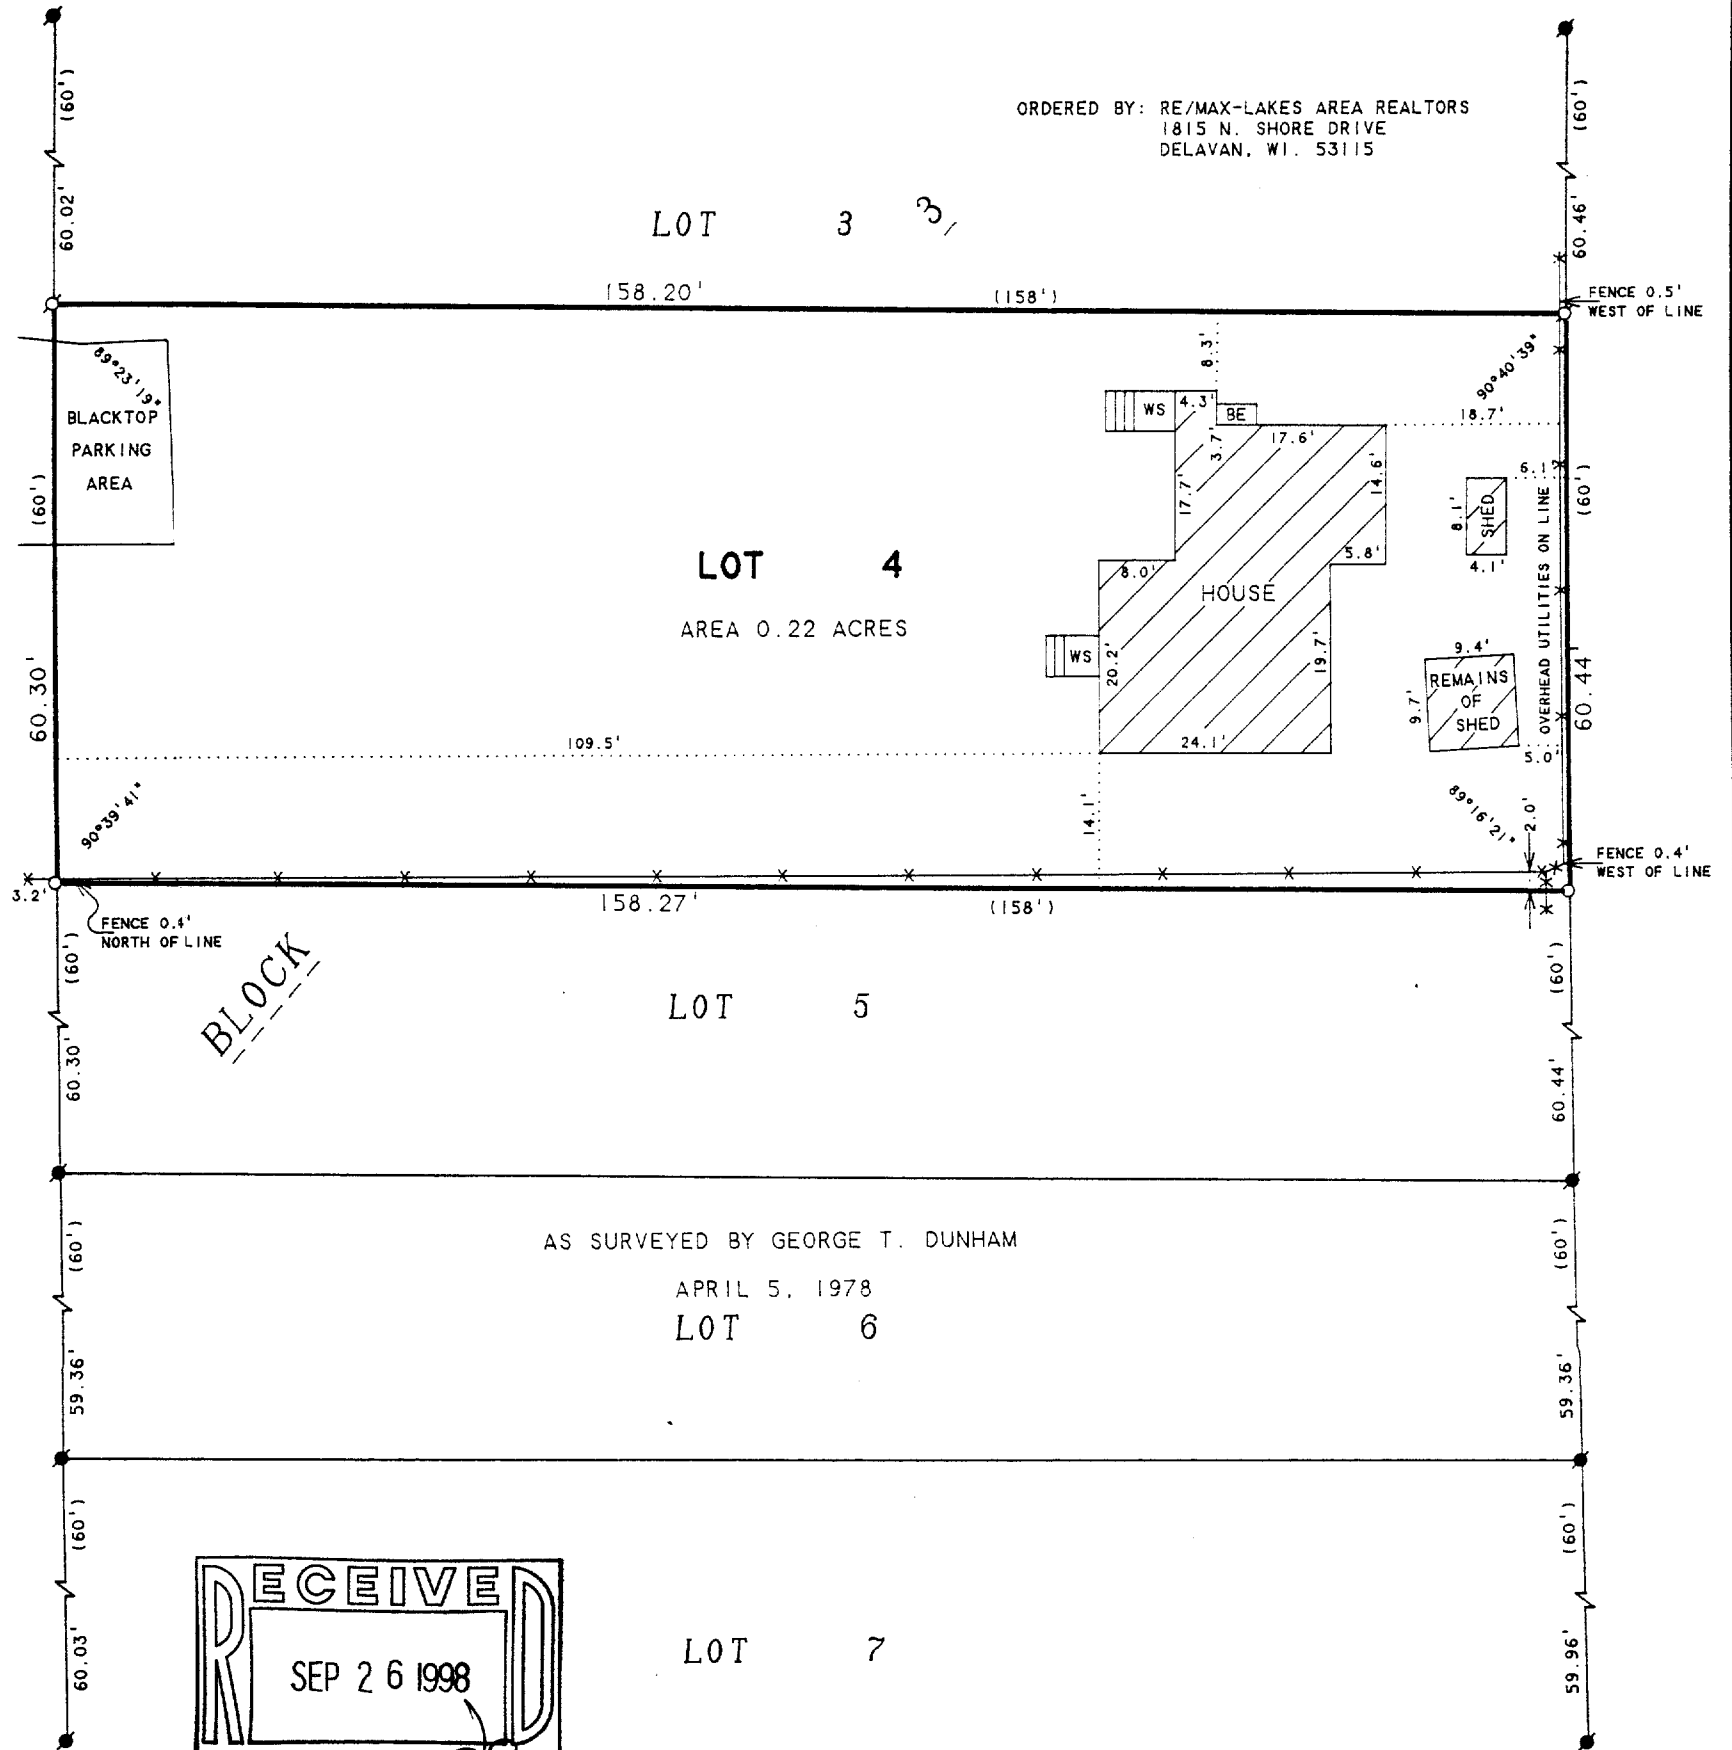

ORDERED BY: RE/MAX-LAKES AREA REALTORS
1815 N. SHORE DRIVE
DELAVAN, WI. 53115

LOT 3

158.20' (158')

LOT 4
AREA 0.22 ACRES

109.5'
158.27' (158')

LOT 5

AS SURVEYED BY GEORGE T. DUNHAM

APRIL 5, 1978

LOT 6

LOT 7

RECEIVED
SEP 26 1998

011-1315
WHV-36A