

PLAT OF SURVEY


PATHFINDER SURVEYING
 FORMERLY KOLB LAND CONSULTING
 929 WILLIAMS STREET LAKE GENEVA, WI. 53147
 (414) 248-3697

ORDERED BY: THERESA SCHROEDER
 2403 MICHAEL MANOR
 ARLINGTON HEIGHTS, IL. 60004


DATE: 11/3/1998

DESCRIPTION: LOT 51 OF SUMMER HAVEN LOCATED IN THE
 SE 1/4 SECTION 1, T1N, R16E, VILLAGE OF
 WILLIAMS BAY, WALWORTH COUNTY
 WISCONSIN.

LIECHTY DRIVE (30') WIDE

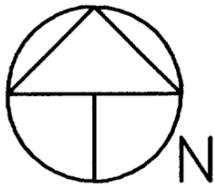

SCALE 1"=20'
 BEARINGS REFERENCED TO
 SURVEY NUMBER 11-1162
 RECORDED IN THE WALWORTH
 COUNTY SURVEYORS OFFICE.

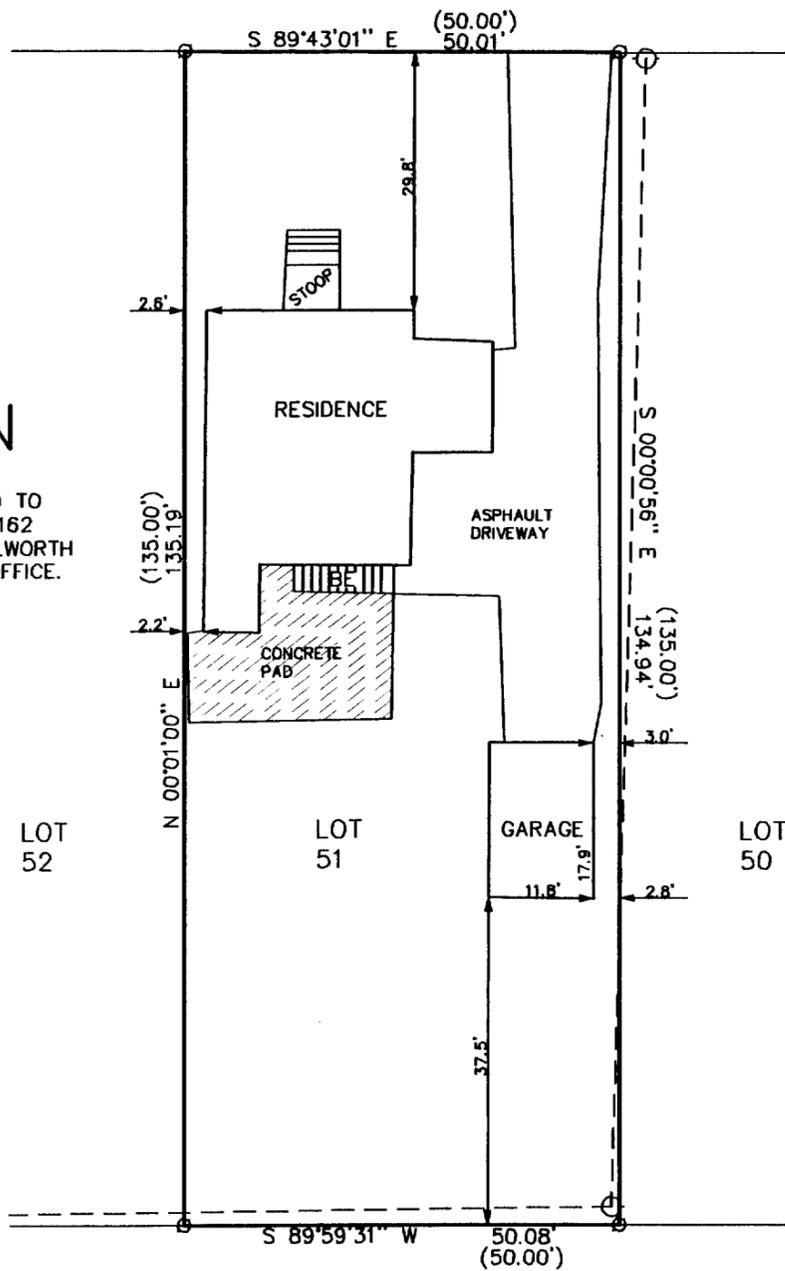


LEGEND

- ⊙ FOUND IRON PIPE
- BE BASEMENT ENTRANCE
- (XXX) RECORDED AS
- OVER HEAD ELECTRIC
- ⊙ POWER POLE

THE ABOVE MAP IS A TRUE REPRESENTATION THEREOF AND
 SHOWS THE SIZE AND LOCATION OF ALL THE PROPERTY,
 EXTERIOR BOUNDARIES, THE LOCATION OF ALL VISIBLE
 BOUNDARY FENCES, APPARENT EASEMENTS, ROADWAYS
 AND VISIBLE ENCROACHMENTS, IF ANY

THIS SURVEY IS MADE FOR THE USE OF THE PRESENT
 OWNERS OF THE PROPERTY, AND ALSO THOSE WHO
 PURCHASE, MORTGAGE OR GUARANTEE TITLE THERETO
 WITHIN ONE (1) YEAR FROM DATE HERETO.

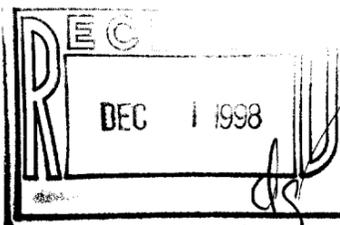

John P. Krott
 JOHN P. KROTT, R.L.S. 2258

NOTE: THIS IS NOT A CERTIFIED COPY
 UNLESS SEAL IS IN RED.
 JOB NUMBER #98215 WSU00043

WSU-43 011-1329