


Plat of Survey

of


Lots 14, 15 and 16 of Carlson's Addition to Williams Bay,
located in the Northeast 1/4 of Section 1, Town 1 North, Range 16 East,
Village of Williams Bay, Walworth County, Wisconsin.

Surveyed for: **Century 21 Affiliated - Southern Lakes**


50 West Geneva Street
Williams Bay, Wisconsin. 53191

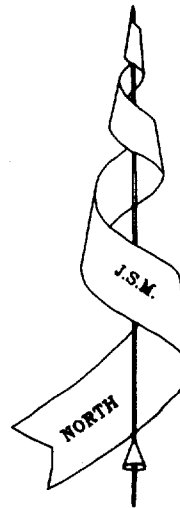

Bearings referenced to
previous surveys.

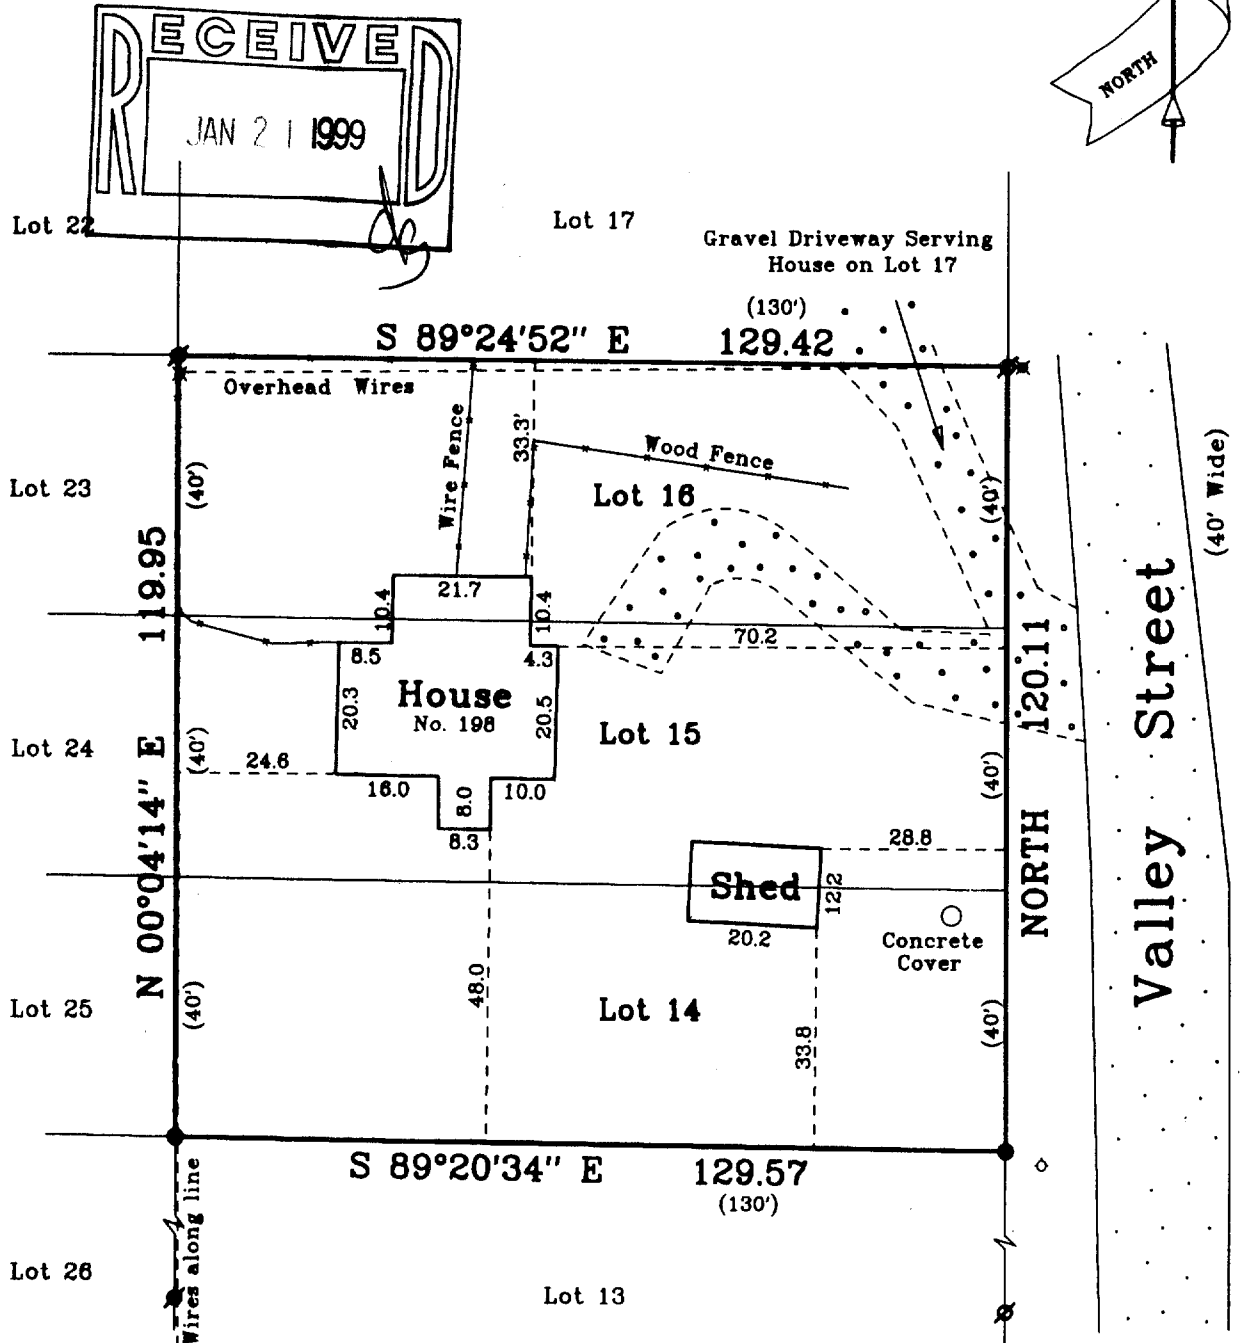

Copy _____ of _____

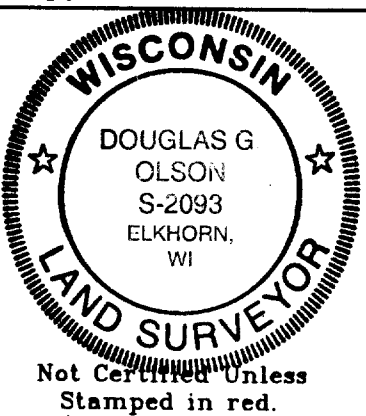

Note: This survey is subject to Wisconsin lien laws.
This Plat of Survey is the notice of intent
to file lien. Lien waiver required.

Note: This survey plat is not
certified unless signed
and sealed in red ink.

Copyright © 1998 by Jensen & Olson Land Surveying, LLC

All rights reserved. No part of this survey plat may be reproduced
or transmitted in any form by any means - graphic, electronic, or
mechanical, including photocopying, tracing, or information storage
and retrieval systems - without permission in writing from Douglas G.
Olson, Jensen & Olson Land Surveying, LLC.

I, Douglas G. Olson, Wisconsin Registered Land Surveyor, do
hereby certify that this survey was performed by me, or under my
direction in full compliance with the owner's / agent's instructions
and Chapter A-E 7 of the Wisconsin Administrative Code "Minimum
Standards for Property Surveys"; and that this map is as accurate
representation thereof to the best of my knowledge and belief.

Date: 10-9-1998

D.G.O.
Douglas G. Olson R.L.S. 2093

Legend

- Found Iron Pipe
- Set Iron Rod, 3/4" dia.
- () Recorded Information
- Gravel Surface
- Utility Pole
- Hydrant
- Asphalt Surface

Jensen & Olson Land Surveying, LLC

45 South Wisconsin Street P.O. Box 322

Elkhorn, Wisconsin. 53121

Telephone: (414) 723-3434

Facsimile: (414) 723-8044

Mapping Date: Oct. 6, 1998.


Revisions: Oct. 9, 1998.

Sheet 1 of 1 Sheets

Job Reference No.

1998.081

Scale in feet: 1" = 30'

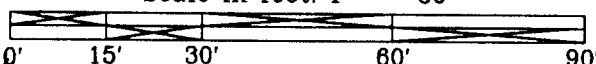

WCA-6
WCA-7

011-1334