
A parcel of land located in the East 1/2 of the Southeast 1/4 of Section 1, Town 1 North, Range 16 East of Walworth County, Wisconsin, described as follows: Commencing at the North 1/16th Section corner of the Southeast 1/4 of said Section 1 and run thence North 87° 25' East along the East-West 1/4 Section line and the centerline of Congress Street, 479.23 feet to the point of beginning of the parcel of land hereinafter described; thence continue North 87° 25' East along said line 100.00 feet; thence South 2° 35' East 283.96 feet; thence South 88° 50' West 100.00 feet; thence North 2° 35' West 281.52 feet to the point of beginning.



I, Thomas F. A. Jensen, Wisconsin Registered Land Surveyor, hereby certify that this survey was performed by me, or under my direction, in full compliance with the owner's/agent's instructions, and that this map is an accurate representation thereof to the best of my knowledge and belief.

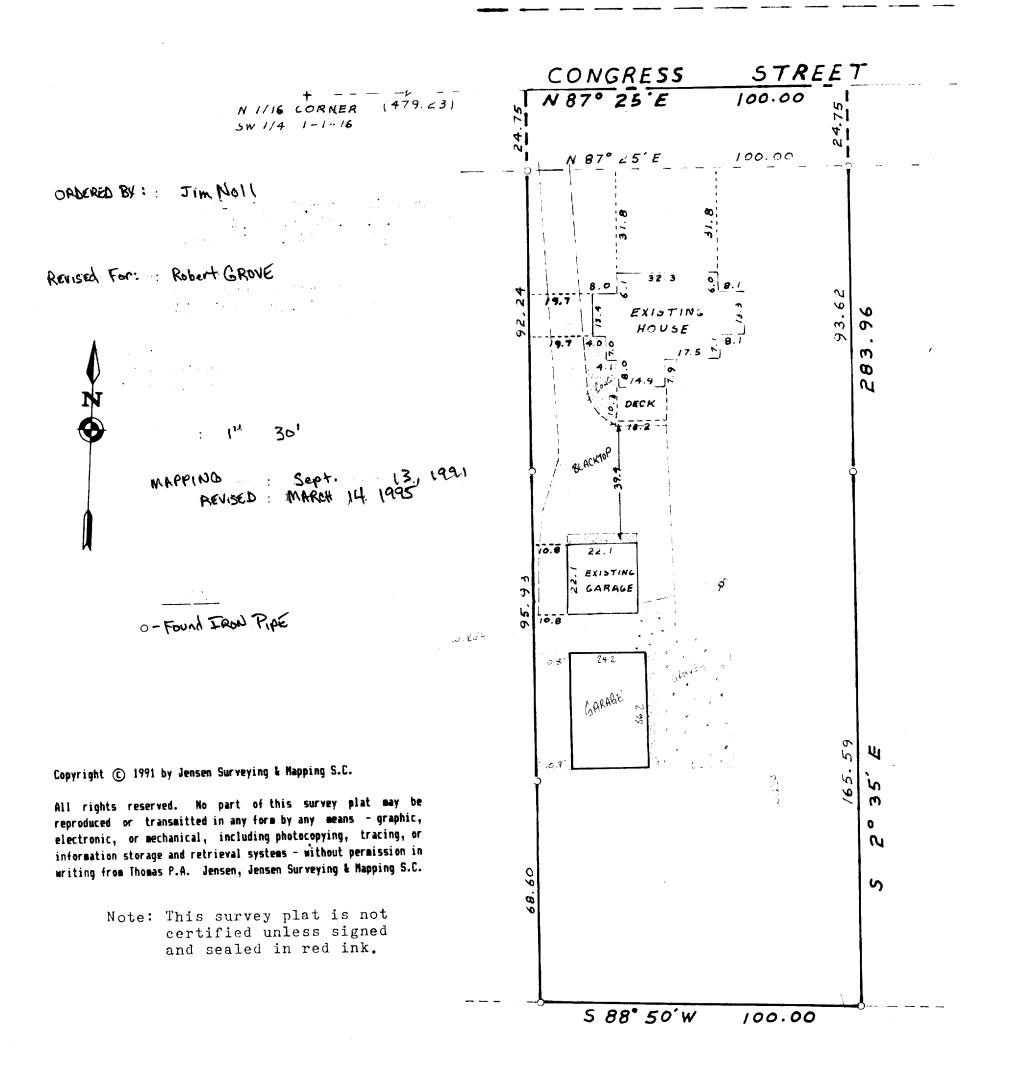

Thomas P. A. Jensen, R.L.S.-1084 JENSEN SURVEYING & MAPPING, S.C.

> 011-1342 WWUP-51B