

LOT 3 OF C.S.M. 2075
VILLAGE OF WILLIAMS BAY,
WALWORTH COUNTY, WISCONSIN

WORK ORDERED BY -
KLEIN EDY
ORREN PICKELL BUILDERS, INC.
2201 WALKER ROAD
BANNOCK BURN, IL 60015

FARRIS, HANSEN & ASSOCIATES, INC.
Engineering, Architecture, Surveying
7 Ridgeway Court P.O. Box 437
ELKHORN, WISCONSIN 53121
Office: (414) 723-2088
Fax: (414) 723-5686

REVISIONS


PROJECT NO.
4934
DATE
07/21/98
SHEET NO.
1 OF 1

PLAT OF SURVEY LOT 3 OF C.S.M. 2075

LOCATED IN THE NW 1/4 OF THE SE 1/4 OF
SECTION 1, TOWN 1 NORTH, RANGE 16 EAST, VILLAGE
OF WILLIAMS BAY, WALWORTH COUNTY, WISCONSIN

LEGEND
O = FOUND IRON PIPE STAKE, 1" DIA.
⊗ = FOUND 1/4" IRON ROD IN CONCRETE
(XXX) = RECORDED AS

LOT 3 SETBACKS:
1. RESIDENCE FACING PARK STREET.
THE SETBACK LINES SHALL BE LINES
1-2 AND 2-3.
2. RESIDENCE FACING DARTMOUTH
STREET, THE SETBACK LINES SHALL
BE LINES 4-5 AND 5-6.

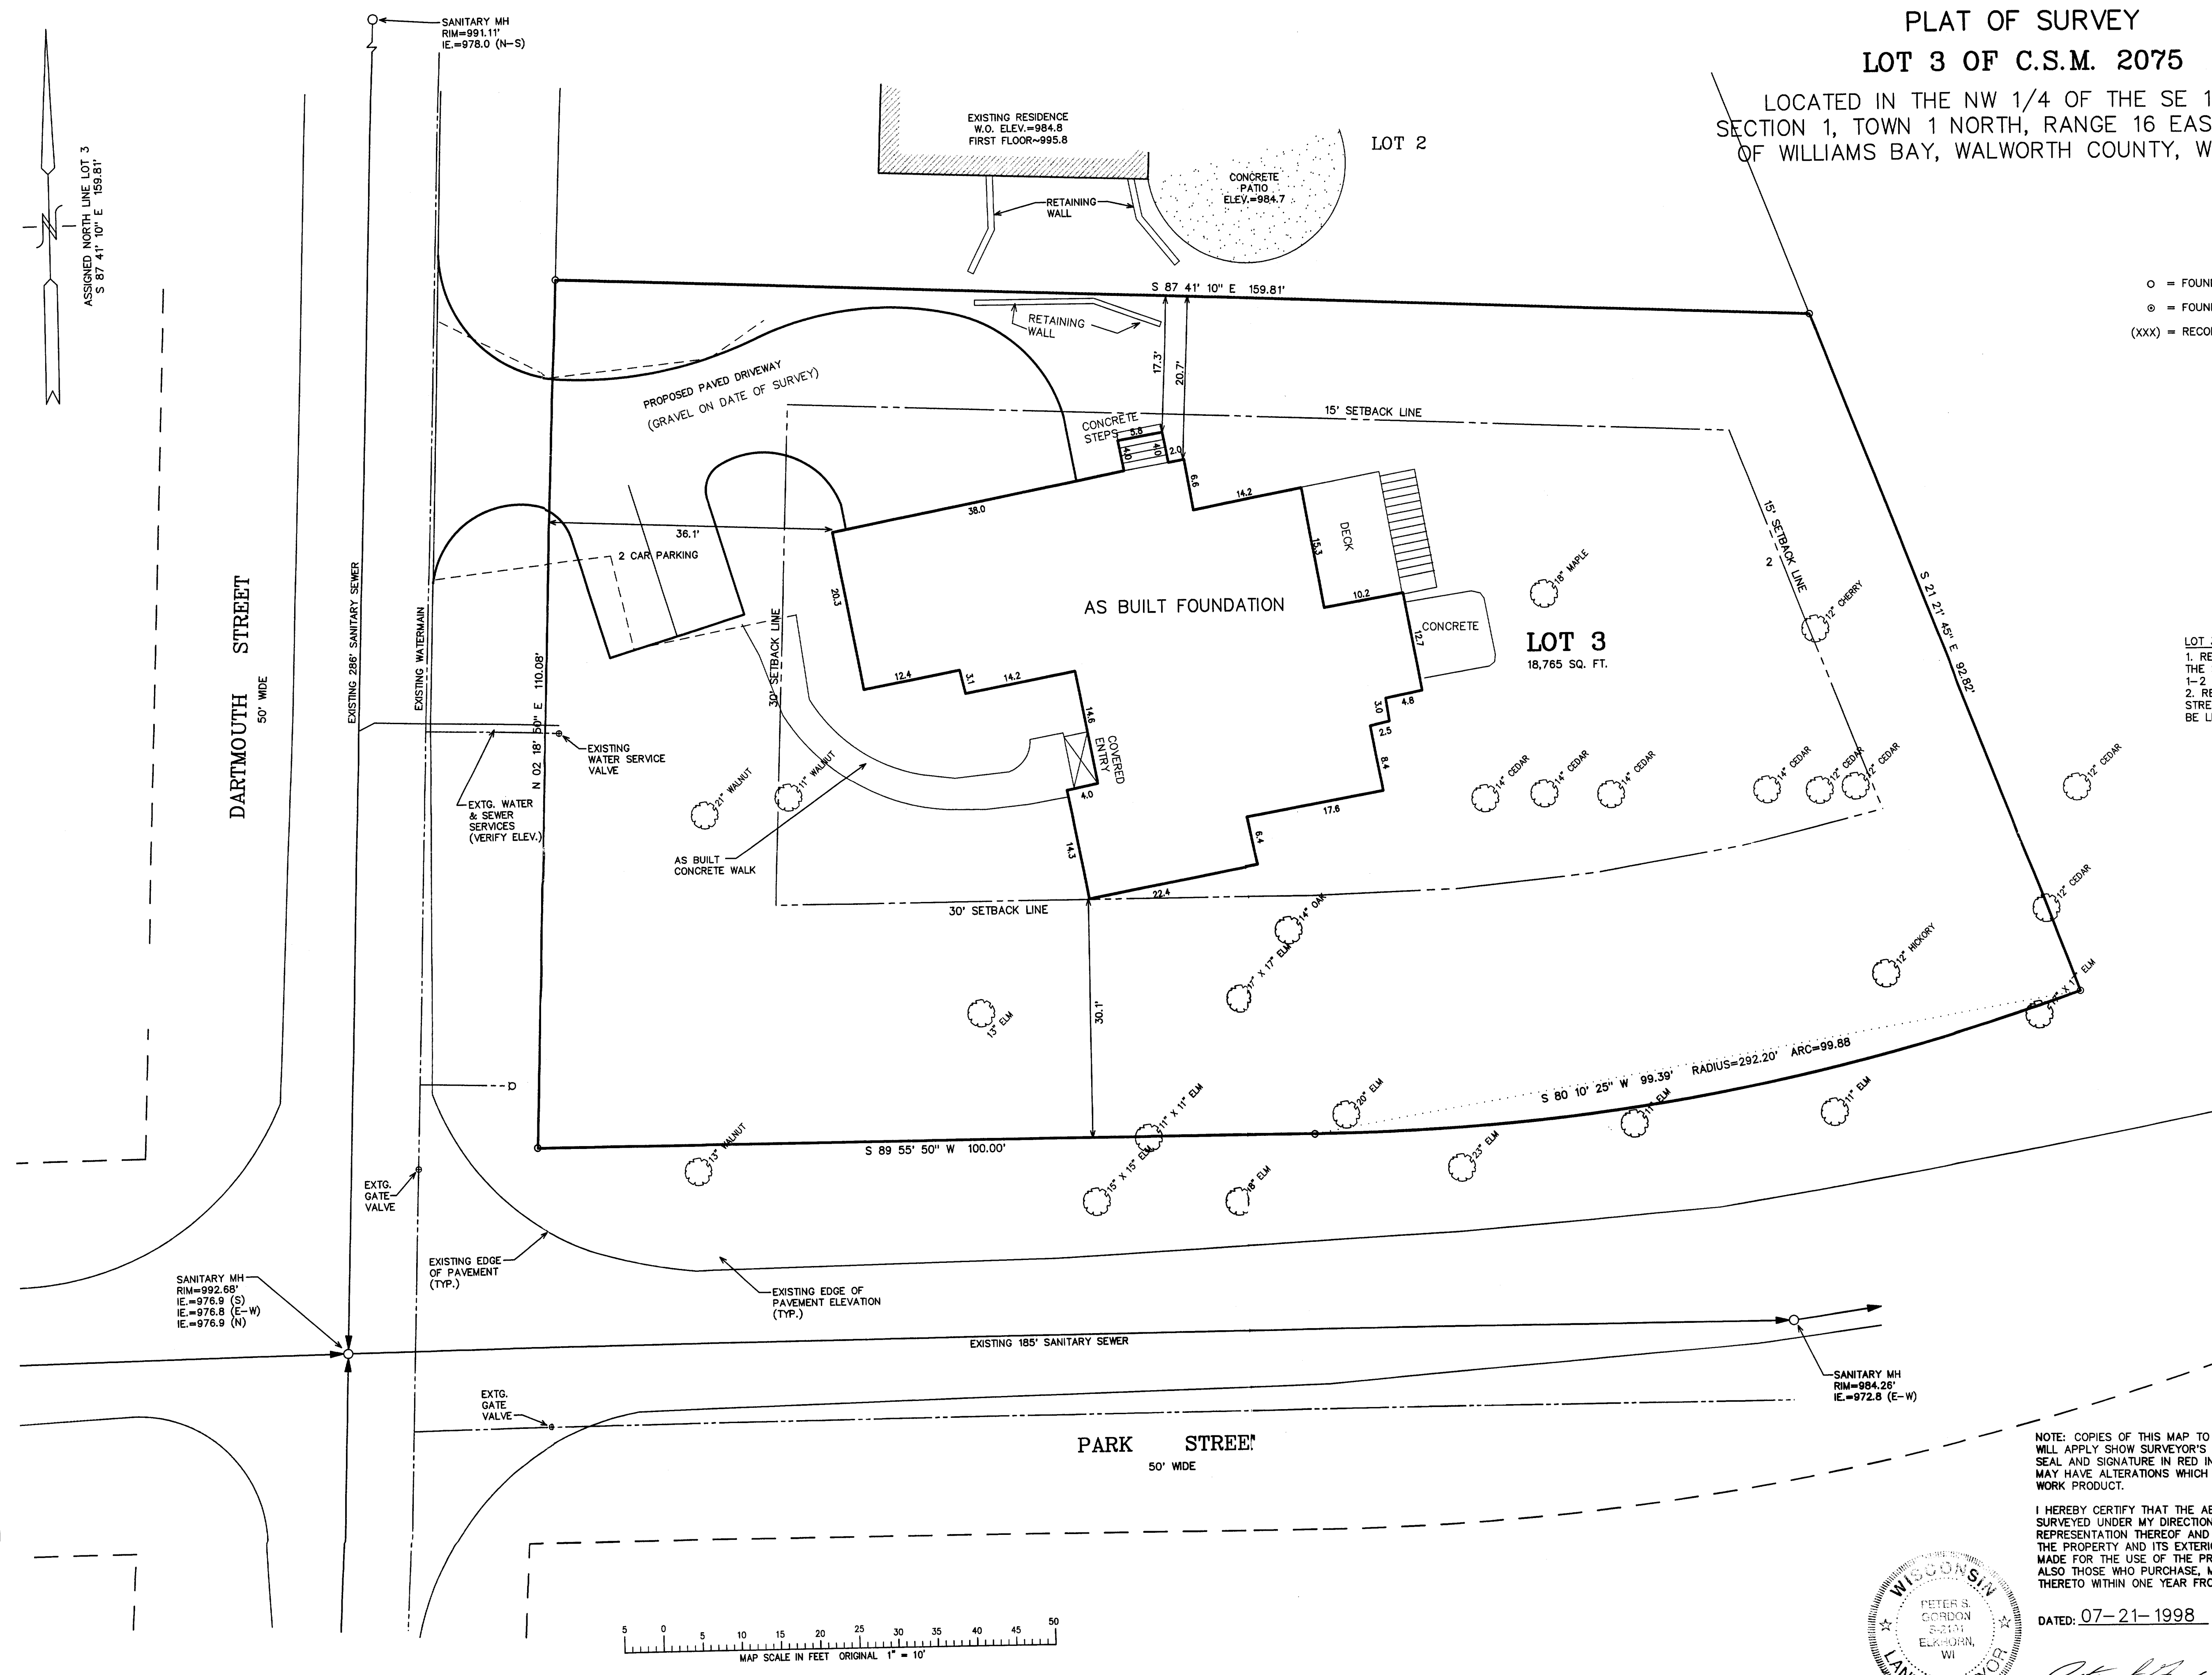




NOTE: COPIES OF THIS MAP TO WHICH THE FOLLOWING CERTIFICATE
WILL APPLY, SHOW SURVEYOR'S ORIGINAL
SEAL AND SIGNATURE IN RED INK. COPIES BY ANY OTHER MEANS
MAY HAVE ALTERATIONS WHICH DO NOT REPRESENT THE SURVEYOR'S
WORK PRODUCT.

I HEREBY CERTIFY THAT THE ABOVE DESCRIBED PROPERTY HAS BEEN
SURVEYED UNDER MY DIRECTION AND THAT THE ABOVE MAP IS A TRUE
REPRESENTATION THEREOF AND SHOWS THE SIZE AND LOCATION OF
THE PROPERTY AND ITS EXTERIOR BOUNDARIES. THIS SURVEY IS
MADE FOR THE USE OF THE PRESENT OWNERS OF THE PROPERTY, AND
ALSO THOSE WHO PURCHASE, MORTGAGE, OR GUARANTEE THE TITLE
THERE TO WITHIN ONE YEAR FROM THE DATE HEREOF.

DATED: 07-21-1998

PETER S. GORDON
R.L.S. 2101

REVISED 01-21-1998
TO SHOW SIZE & LOCATION
OF FOUNDATION
AS BUILT
REV. 06-25-99
UPDATE IMPROVEMENTS

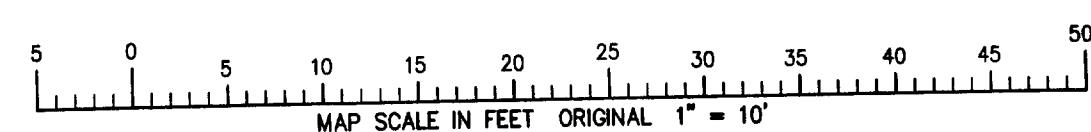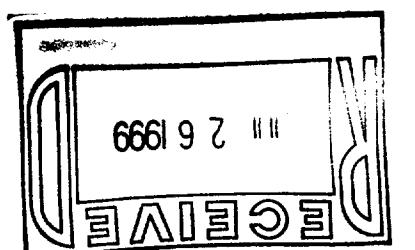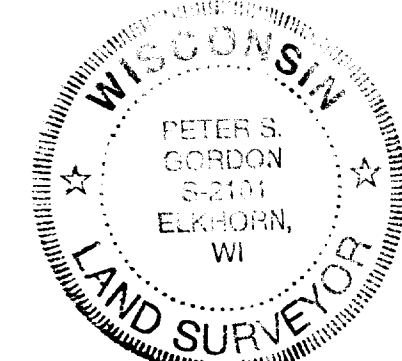

WA-2075-3

011-1361