

FARRIS, HANSEN & ASSOCIATES, INC.


7 RIDGEWAY COURT, P.O. BOX 487, ELKHORN, WISCONSIN

TEL. 414-723-2098

LOCATION: LOT 40 OF WILLABAY WOODS IN SEC. 6-1-17
VILLAGE OF WILLIAMS BAY, WALWORTH CO., WI.

MAP LEGEND

- = IRON PIPE STAKE FOUND
- = IRON PIPE STAKE SET
- = IRON ROD STAKE FOUND
- = IRON ROD STAKE SET
- = CONCRETE MONUMENT FOUND
- (XXXXX) = RECORD DIMENSION

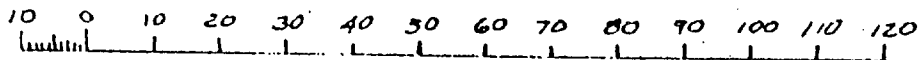


MAP SCALE IN FEET

N



S. LINE LOT 40 ASSIGNED THE
BEARING N 89° 25' W AS
RECORDED AS THE BASIS
FOR BEARINGS ON THIS PLAT

WORK ORDERED BY:
KEEFE REAL ESTATE
704 W. MAIN STREET
LAKE GENEVA, WISCONSIN 53147

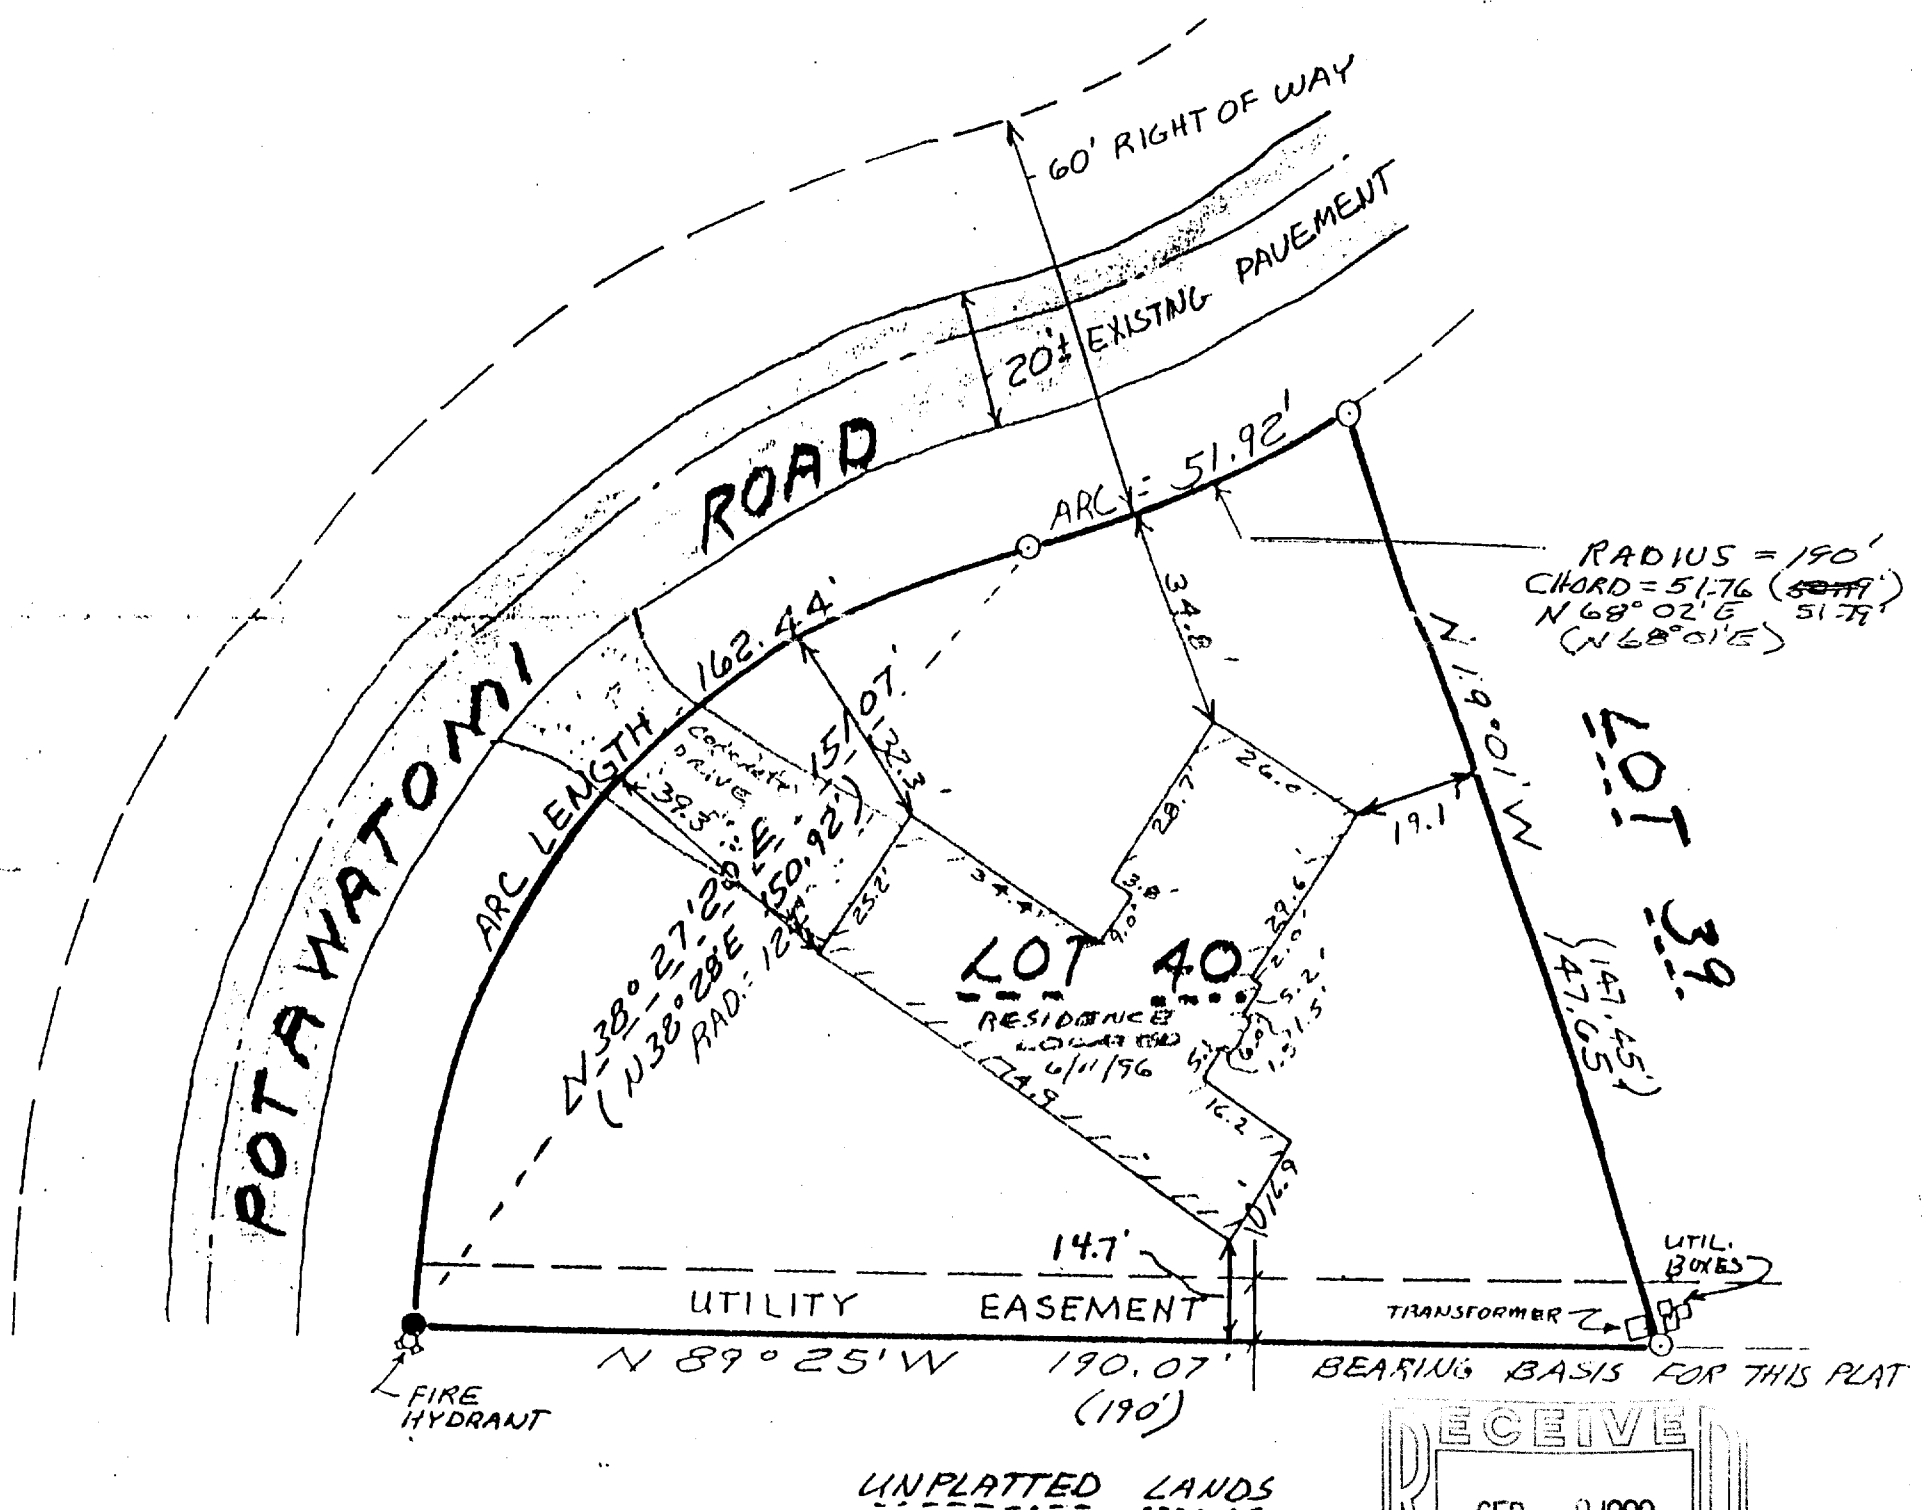

NOTE: COPIES OF THIS MAP TO WHICH THE FOLLOWING CERTIFICATE WILL APPLY
ORIGINAL SEAL AND SIGNATURE IN RED INK. COPIES BY ANY OTHER MEANS MAY HAVE ALTERATIONS WHICH DO NOT
REPRESENT THE SURVEYOR'S WORK PRODUCT.

SHOW SURVEYOR'S


I HEREBY CERTIFY THAT THE ABOVE DESCRIBED PROPERTY HAS BEEN SURVEYED UNDER MY DIRECTION AND THAT THE ABOVE MAP IS A
TRUE REPRESENTATION THEREOF AND SHOWS THE SIZE AND LOCATION OF THE PROPERTY AND ITS EXTERIOR BOUNDARIES. THIS SURVEY
IS MADE FOR THE USE OF THE PRESENT OWNERS OF THE PROPERTY, AND ALSO THOSE WHO PURCHASE, MORTGAGE, OR GUARANTEE
THE TITLE THERETO WITHIN ONE YEAR FROM THE DATE HEREOF.

DATED: 4/22/1996

REVISED 06/12/1996 ADD INTERIOR DETAIL

REVISED 7-27-99 - RESURVEY

WUW-40 011-1369

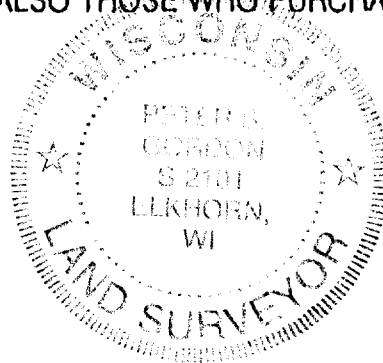

PROJECT NO. 3004