




PLAT OF SURVEY

PATHFINDER SURVEYING
 FORMERLY KOLB LAND CONSULTING
 929 WILLIAMS STREET LAKE GENEVA, WI. 53147
 (414) 248-3697

DATE: 9-9-1999

ORDERED BY: COLDWELL BANKER GENEVA LAKES AREA REALTORS
 838 W MAIN ST.
 LAKE GENEVA, WI. 53147


DESCRIPTION: LOT 1 OF CERTIFIED SURVEY MAP NO. 772 LOCATED
 IN THE NORTHWEST 1/4 OF SECTION 1, TOWN 1 NORTH
 RANGE 16 EAST, VILLAGE OF WILLIAMS BAY, WALWORTH
 COUNTY, WISCONSIN.

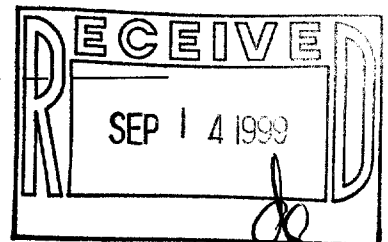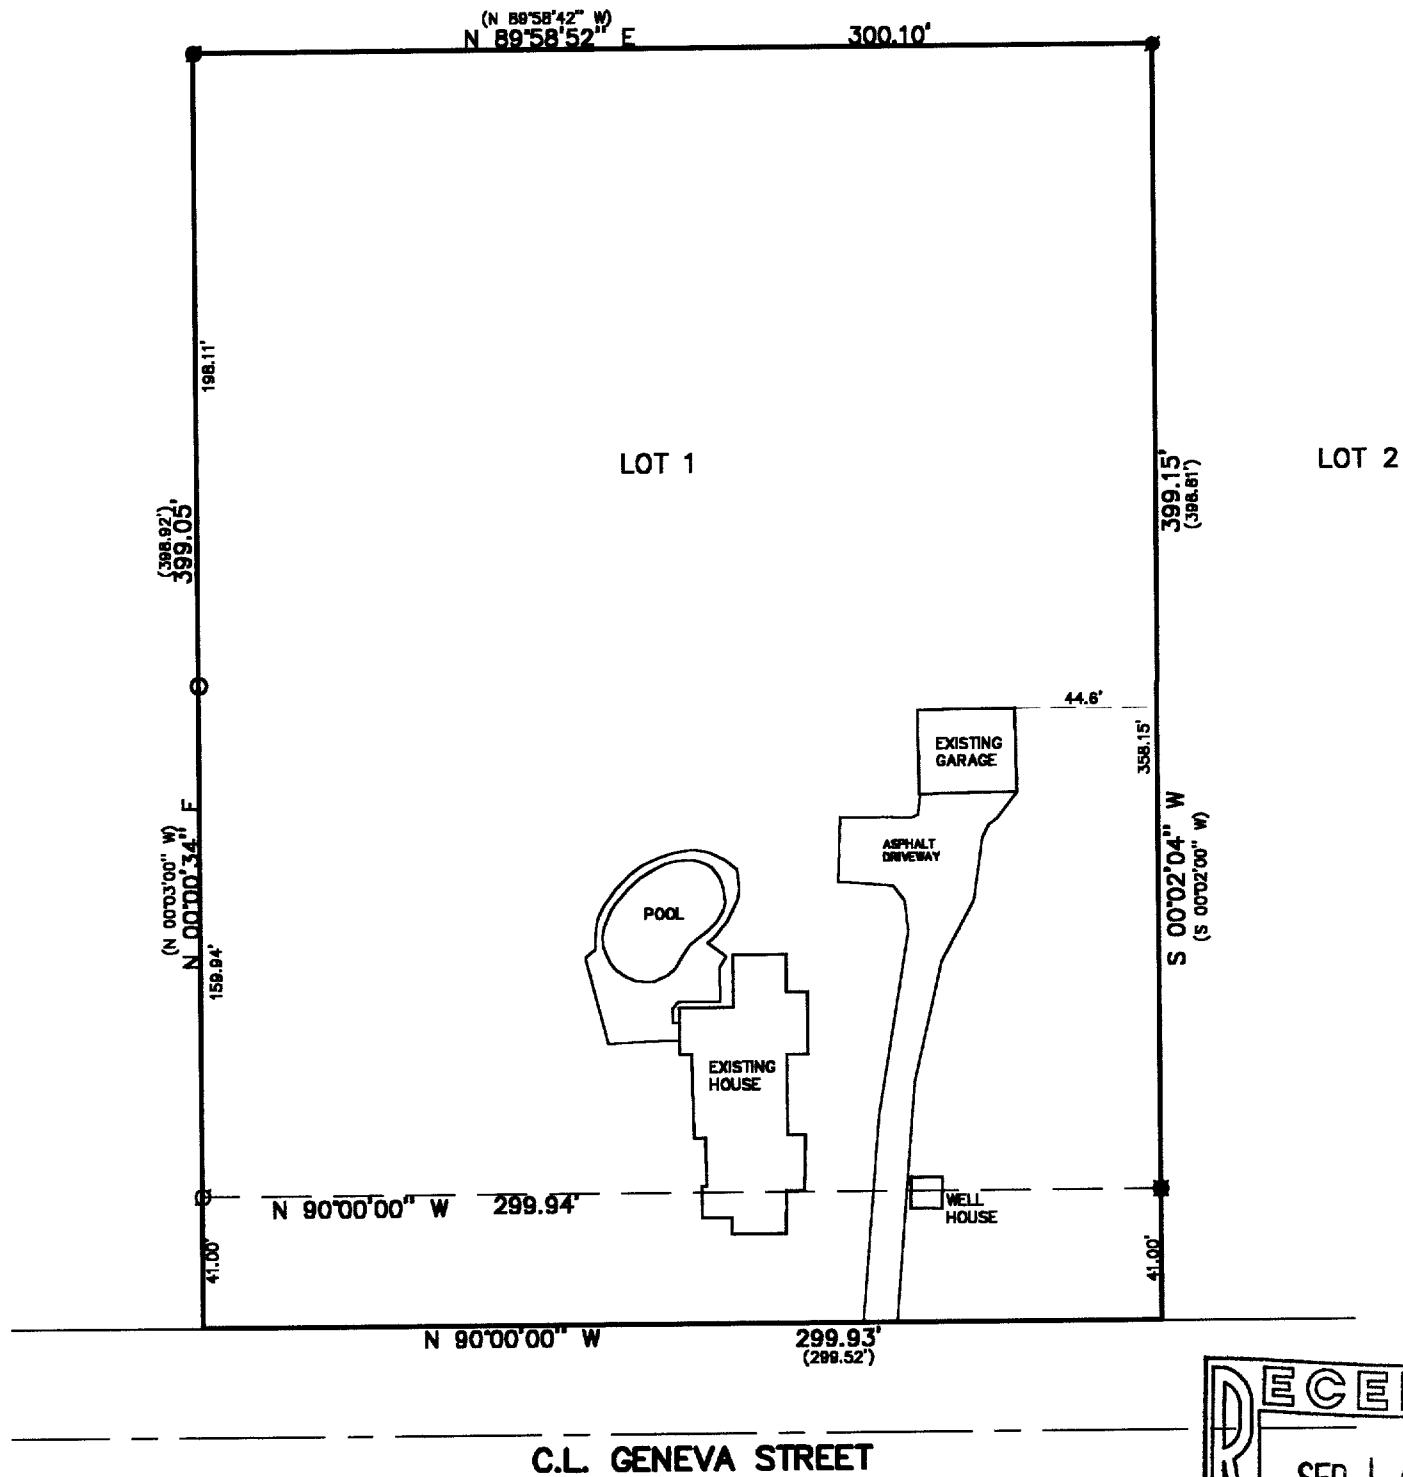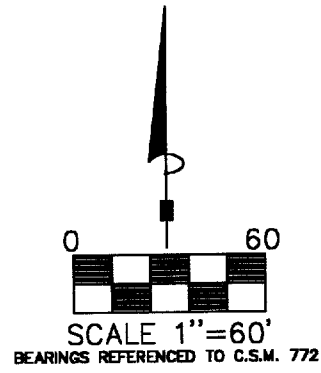

THE ABOVE MAP IS A TRUE REPRESENTATION THEREOF AND
 SHOWS THE SIZE AND LOCATION OF ALL THE PROPERTY,
 EXTERIOR BOUNDARIES, THE LOCATION OF ALL VISIBLE
 BOUNDARY FENCES, APPARENT EASEMENTS, ROADWAYS
 AND VISIBLE ENCROACHMENTS, IF ANY

THIS SURVEY IS MADE FOR THE USE OF THE PRESENT
 OWNERS OF THE PROPERTY, AND ALSO THOSE WHO
 PURCHASE, MORTGAGE OR GUARANTEE TITLE THERETO
 WITHIN ONE (1) YEAR FROM DATE HERETO.

- LEGEND
- FOUND 1" IRON PIPE
 - SET 1" IRON PIPE
 - FOUND 2" IRON PIPE
 - FOUND IRON PIN
 - (XXXX) RECORDED AS

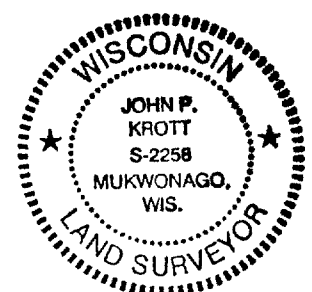

John P. Krott
 JOHN P. KROTT, R.L.S. 2258

NOTE: THIS IS NOT A CERTIFIED COPY
 UNLESS SEAL IS IN RED.

JOB NUMBER #99204 1-16 WA 772 0001

WA-772-1
 11-1372