

SHEET 1 OF 2 SHEETS

ABELL SURVEYING & MAPPING SPRING DELAVAN, WISCONSIN 53115 414-728-6737 STREET


ORIGINAL PLAT OF THE VILLAGE OF WILLIAMS BAY LOT 6 BLOCK 5

66' WIDE

RECERTIFIED-10/12/99 ORDERED BY: MARSHA REIFF P.O. BOX 532 WILLIAMS BAY, WI 53191

NOTE: BEARINGS ARE REFERENCED TO EXISTING SURVEY RECORDS.

ORDERED BY: KEEFE REAL ESTATE P.O. BOX 460 LAKE GENEVA, WI 53147

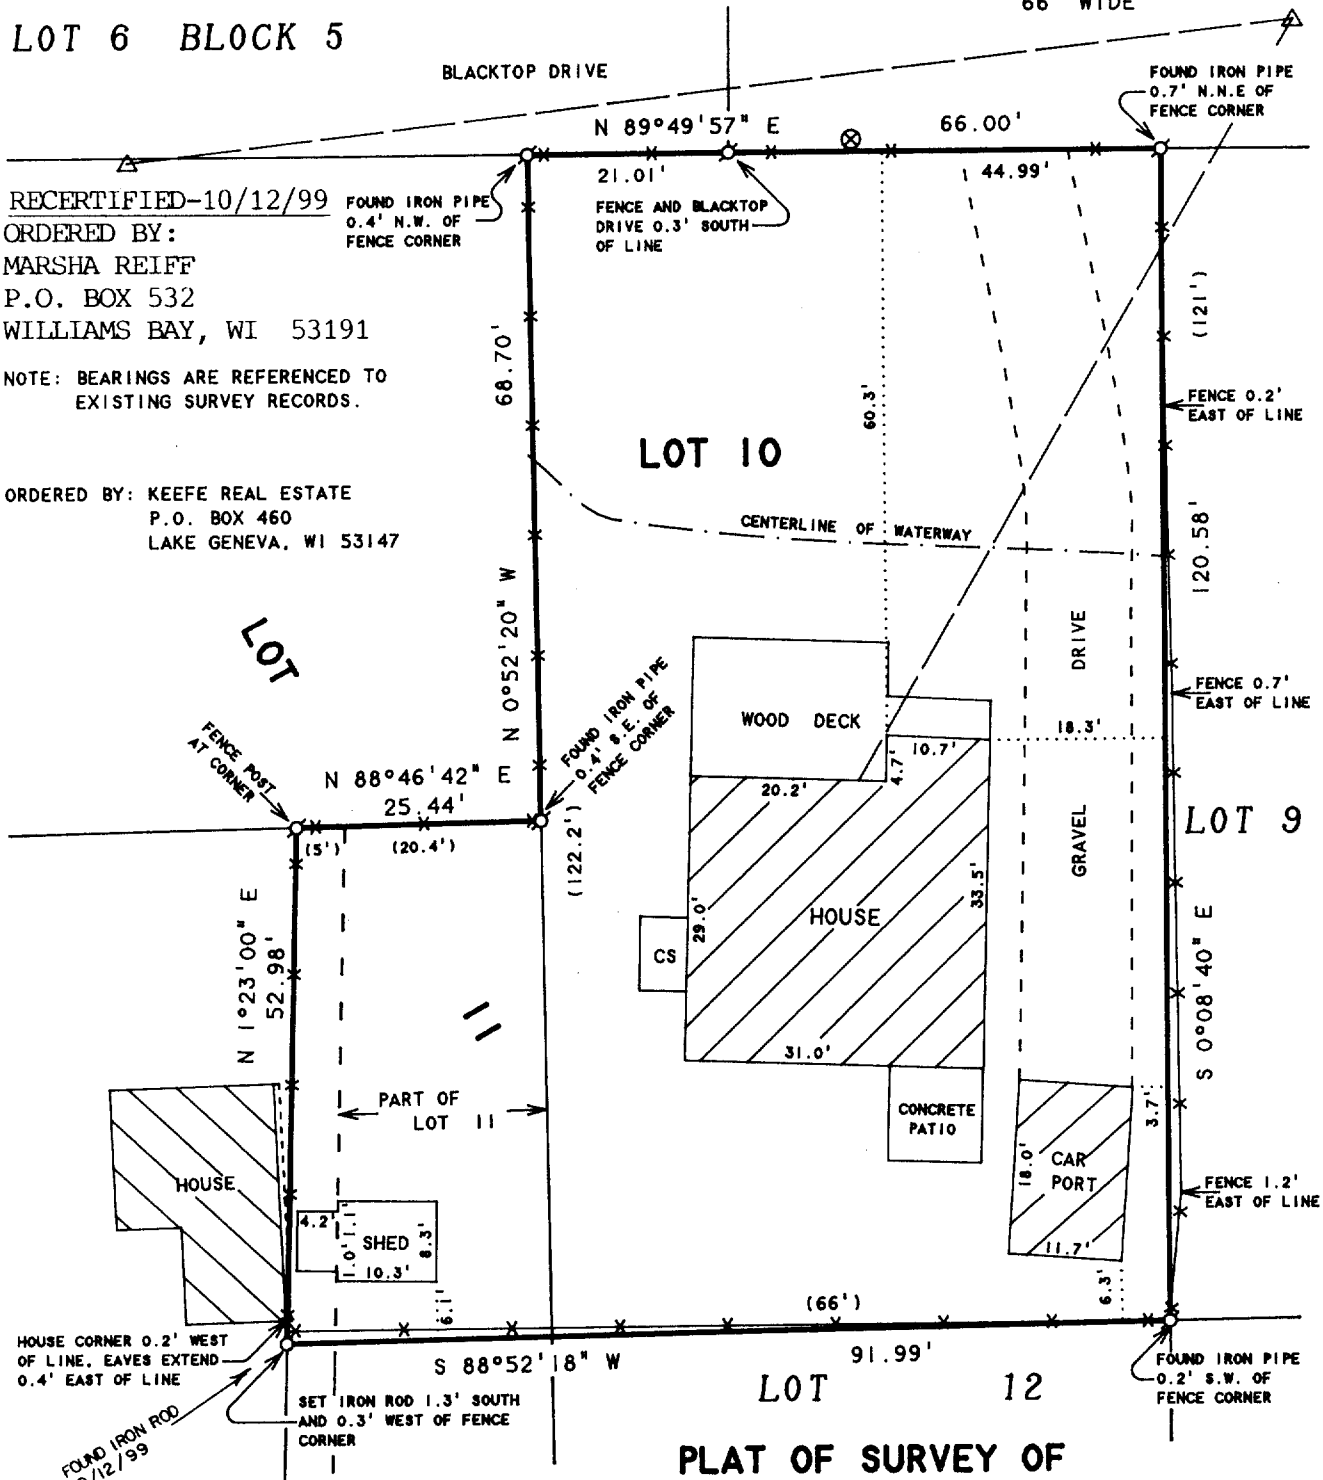

PLAT OF SURVEY OF

LOT 10 AND PART OF LOT 11 OF JOHNSON'S ADDITION TO THE VILLAGE OF WILLIAMS BAY, AND A PARCEL OF LAND LYING JUST WEST OF PART OF LOT 11, ALL IN WALWORTH COUNTY, WISCONSIN.

I HEREBY CERTIFY THAT I HAVE SURVEYED THE ABOVE DESCRIBED PROPERTY AND THAT THE ABOVE MAP IS A TRUE REPRESENTATION THEREOF AND SHOWS THE SIZE AND LOCATION OF THE PROPERTY, ITS EXTERIOR BOUNDARIES, THE LOCATION OF ALL VISIBLE STRUCTURES AND DIMENSIONS OF ALL PRINCIPAL BUILDINGS THEREON, BOUNDARY FENCES, APPARENT EASEMENTS, ROADWAYS AND VISIBLE ENCROACHMENTS, IF ANY, TO THE BEST OF MY KNOWLEDGE AND BELIEF.

THIS SURVEY IS MADE FOR THE USE OF THE PRESENT OWNERS OF THE PROPERTY, AND ALSO THOSE WHO PURCHASE, MORTGAGE, OR GUARANTEE THE TITLE THERETO WITHIN ONE (1) YEAR FROM DATE HEREON.

David F. Abell signature

DAVID F. ABELL WISCONSIN REGISTERED LAND SURVEYOR, S-1596

August 26, 1994

RECERTIFIED - 10/12/99

DATE: August 26, 1994 JOB NUMBER - 94150 NOTE: THIS IS NOT A CERTIFIED COPY UNLESS SEALED.



SCALE 1"=20'

LEGEND

- Legend items: IRON PIPE FOUND, IRON ROD SET, FENCE, CONCRETE STOOP, UTILITY POLE, OVERHEAD UTILITY LINES, MANHOLE COVER, RECORDED AS

WJA-8

011-1409

**ABELL
SURVEYING & MAPPING
DELAVAN, WISCONSIN 53115
414-728-6737**

SHEET 2 OF 2 SHEETS

LEGAL DESCRIPTION

Lot 10 of Johnson's Addition to the Village of Williams Bay, Walworth County, Wisconsin. ALSO that part of Lot 11 of said subdivision described as follows, to-wit: Beginning at the SE corner of said Lot 11; thence west along the south line of said Lot 11, 26 feet to the most S'y SW corner of said Lot 11; thence north along the west line of said Lot 11, 222.70 feet to a point; thence east 20.4 feet to the east line of said Lot 11; thence South along the east line of said lot 11, 222.70 feet to the place of beginning, also a parcel of land lying just west of that part of Lot 11 that is described above, to-wit: Beginning at the most southerly southwest corner of said Lot 11; thence west 5 feet; thence north 222.7 feet to the south line of part of said Lot 11; thence East along the south line of said part of Lot 11, 5 feet; thence south along the line of Lot 11, 222.7 feet to the place of beginning.

EXCEPTING that part of Lot 11 of said subdivision and lands adjoining said Lot 11 on the west described as follows, to-wit: Beginning at the most S'y SE corner of said Lot 11, thence north along the east side of Lot 11, 170 feet to the NW corner of Lot 12, thence west on the north line of Lot 12 extended to the west line of Lot 11 and continue west on the same course 5 feet; thence south and parallel to the west line of Lot 11 to the North line of Congress Street; thence East on the north line of Congress Street 31.00 feet to the place of beginning.

Tax Key Nos. WJA 00008 and WWUP 00038

David F. Abell

DAVID F. ABELL
WISCONSIN REGISTERED LAND SURVEYOR, S-1596

August 26, 1994

RECERTIFIED - 10/12/99

DATE: *August 26, 1994* JOB NUMBER - 94150
NOTE: THIS IS NOT A CERTIFIED COPY UNLESS SEALED.