
PROJECT NO. 3836.08-- 15 DATE: 09/21/99 SHEET NO.

PLAT OF SURVEY LOT 15 OF BLOCK 8 LAKEWOOD TRAILS SUBDIVISION LOCATED IN THE NE 1/4 AND THE NW 1/4 OF THE NW 1/4 OF SECTION 1, TOWN 1 NORTH, RANGE 16 EAST, VILLAGE OF WILLIAMS BAY, WALWORTH COUNTY, WISCONSIN

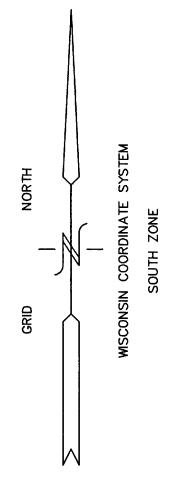

O = FOUND IRON PIPE STAKE 1" DIA.

● = FOUND IRON REBAR STAKE 3/4"

■ = FOUND CONCRETE COUNTY MONUMENT

≠ = FOUND SOLID ROUND IRON BAR STAKE 1 5/16"

(XXX) = RECORDED AS

ECEIVEN

JAN 1 9 2000 .

NOTE: GENERAL EASEMENT IS A COMBINATION OF UTILITY, DRAINAGE, AND WALKWAY EASEMENTS.


NOTE: COPIES OF THIS MAP TO WHICH THE FOLLOWING CERTIFICATE WILL APPLY SHOW SURVEYOR'S ORIGINAL SEAL AND SIGNATURE IN RED INK. COPIES BY ANY OTHER MEANS MAY HAVE ALTERATIONS WHICH DO NOT REPRESENT THE SURVEYOR'S WORK PRODUCT.

I HEREBY CERTIFY THAT THE ABOVE DESCRIBED PROPERTY HAS BEEN SURVEYED UNDER MY DIRECTION AND THAT THE ABOVE MAP IS A TRUE REPRESENTATION THEREOF AND SHOWS THE SIZE AND LOCATION OF THE PROPERTY AND ITS EXTERIOR BOUNDARIES. THIS SURVEY IS MADE FOR THE USE OF THE PRESENT OWNERS OF THE PROPERTY, AND ALSO THOSE WHO PURCHASE, MORTGAGE, OR GUARANTEE THE TITLE THERETO WITHIN ONE YEAR FROM THE DATE HEREOF.

DATED: 10-11-99 \_\_\_

REVISED 12-20-99 TO SHOW SIZE & LOCATION OF FOUNDATION AS BUILT

PETER S. GORDON R.L.S. 2101

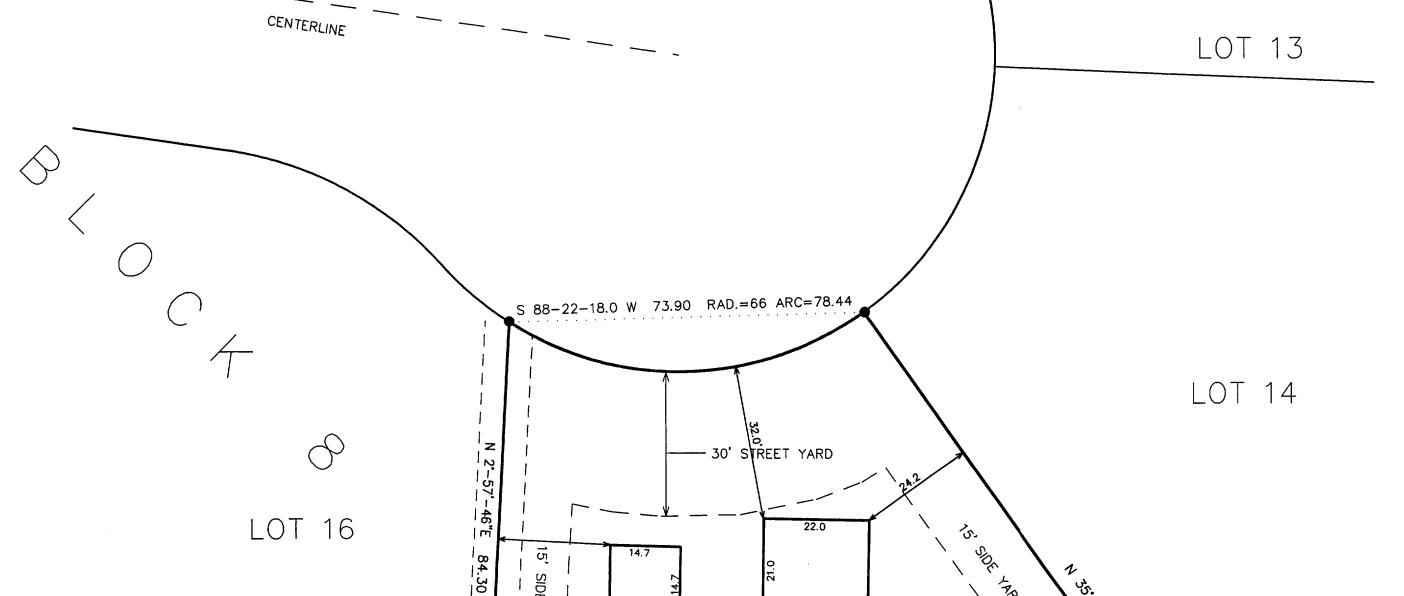

AS BUILT FOUNDATION

- 10' UTILITY EASEMENT

LOT 18

LAKEWOOD

COURT

LOT 17

10 5 0 20 70 80 90 MAP SCALE IN FEET ORIGINAL 1" = 20"

LOT 15 16,917 S.F.

- 30' REAR YARD

163.02

LOT 19

S 88'-51'-40"E

5'

Mrtk-128

1 OF 1