

PLAT OF SURVEY

-OF-

LOTS 14 AND 15 IN CEDAR POINT SUBDIVISION IN SECTIONS 5 AND 6, TOWNSHIP 1 NORTH, RANGE 17 EAST, IN THE VILLAGE OF WILLIAMS BAY, ACCORDING TO THE RECORDED PLAT THERE-OF RECORDED IN THE OFFICE OF THE REGISTER OF DEEDS FOR WALWORTH COUNTY, WISCONSIN.

SURVEY FOR: RE/MAX GENEVA REALTY LTD.

SURVEY LOCATION: 619 CEDAR POINT DRIVE

NOTE: MANHOLES AND STORM DRAINS NOT LOCATED

CEDAR POINT DRIVE

200.00' (199.83' meas.) (50' WIDE) overhead utility lines

89°58'40" fld.

tip is 0.95' southeast of actual corner

90°01'20" fld.



split rail fence

LEGEND


- FOUND IRON PIPE
- UTILITY POLE
- ⊠ FIRE HYDRANT

DETAIL

SCALE: 1" = 30'

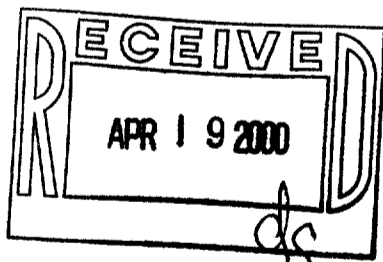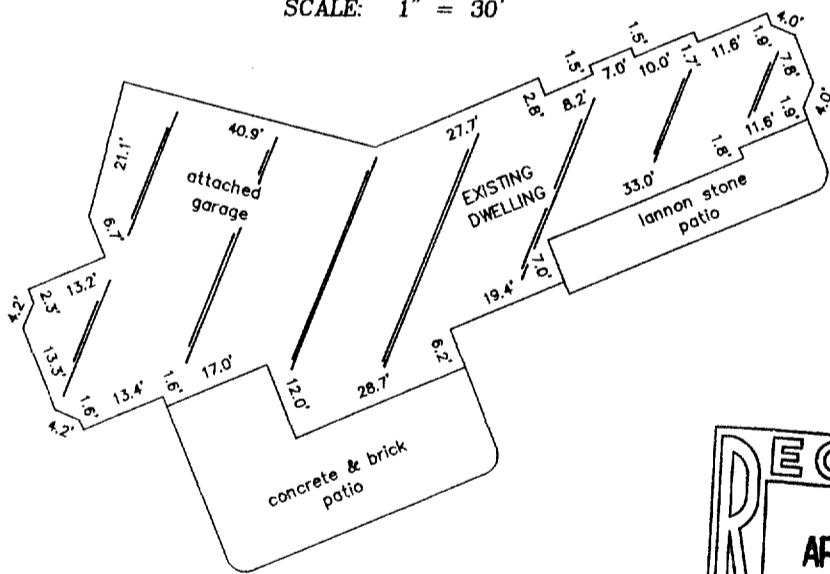

SCALE: 1" = 80'

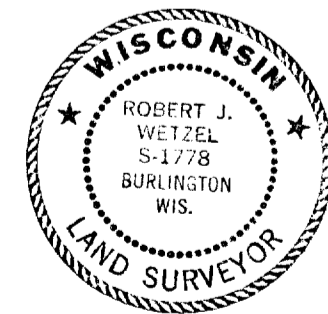


THIS IS NOT AN ORIGINAL PRINT UNLESS THIS SEAL IS RED.

Robert J. Wetzel
ROBERT J. WETZEL S-1778

MARCH 29, 2000
DATE

4378
JOB NUMBER

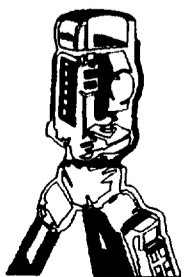

B.W. SURVEYING, INC.

LAND SURVEYS
MAPPING AND PLANNING
412 N. PINE STREET
BURLINGTON, WI 53105
(262)-767-0225

011-1444

WCP4-8