
## PLAT OF SURVEY

PART OF THE NE 1/4 OF SECTION 6 AND PART OF THE NW 1/4 OF SECTION 5, ALL IN T 1 N, R 17 E, TOWN OF LINN, WALWORTH COUNTY, WISCONSON.

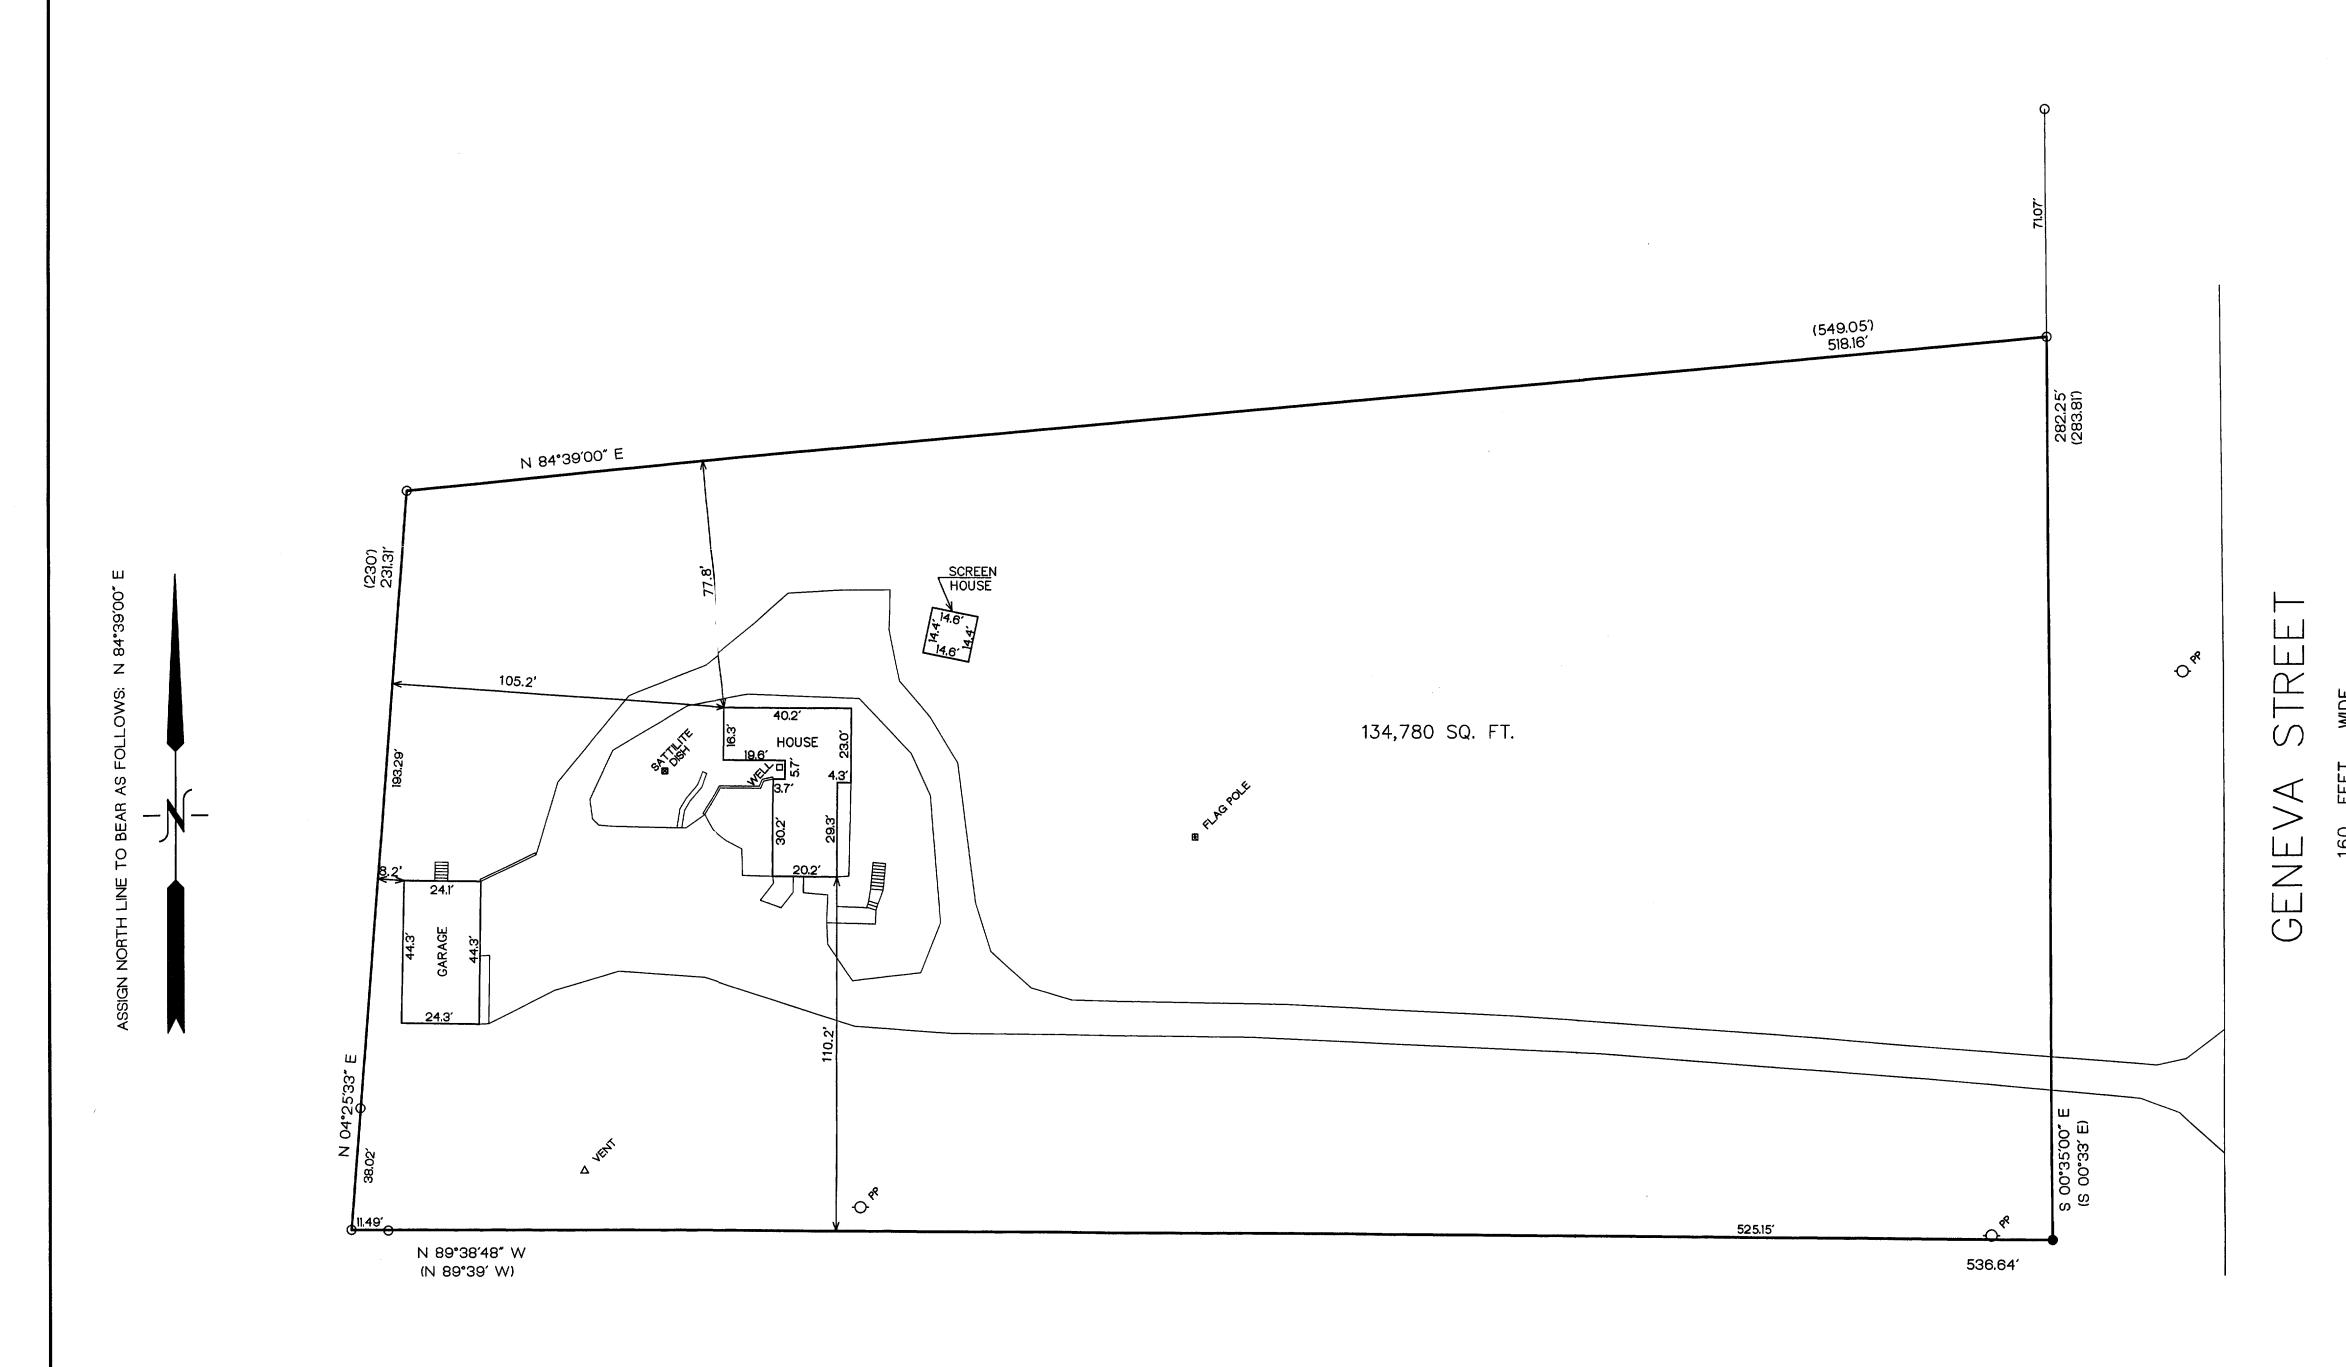

LEGEND

(xx) = RECORDED AS

O = FOUND IRON PIPE STAKE 1" DIA.

• = SET IRON REBAR STAKE 24" X 3/4" X 1.13 LBS./FT.

northeast quarter of Section 5 of Rown 1 Borth, Range 17 East, Welworth County, Eisconsin, described as follows, to-wit: Commencing at the north quarter section corner of said Section 6; thence east along the section line 833.25 feet to a point; thence south 397.20 feet; thence 8 66° 04' E 253.82 feet; thence 8 65° 42' east 211.76 feet; thence 8 68° 07' E 212 feet more or less to a point that is located # 0° 39' E from the northeast corner of the Evangelical Pree Church Subdivision, which point is also the place of beginning: thence 8 88° 07' E 493.12 feet; thence 8 87° 19' E 703.34 feet; thence # 84° 39' E 549.05 feet to the west line of State Trunk Eighensy Mo. 36; thence 8 0° 33' E along said highway 283.81 feet; thence # 69° 39' W 1751.76 feet; thence # 0° 39' E 270 feet to the place of beginning, containing 10.2 acres of land. EXCEPTING therefrom parcel of land described in deed running from Edward Gulund, et al to Evangelical Free Church Hible Conference, more particularly described as follows: A parcel of land located in the Mortheast quarter of Section 6 of Town 1 Morth, Runge 17 East. Malworth County, Wisconsin, described as follows, to-wit: Commencing at the north quarter section corner of said Section 6; thence east along the section line 833.25 feet; thence 8 60' 42' E 211.76 feet; thence 8 88° 07' E 212 feet more or less to a point; thence south 397.20 feet; thence # 66° 04' E 253.82 feet; thence 8 65° 42' E 211.76 feet; thence 8 88° 07' E 212 feet more or less to a point that is located # 0° 39' E from the northeast corner of the Evangelical Free Church Suddivision, which point is also the place of beginning; thence 8 88° 07' E 493.12 feet; thence 8 10° 39' E 703.34 feet; thence 8 along a line which is the boundary line between the Town of Linn and the Village of Milliams Bay a distance of 230 feet to a certain fence line; thence # 89° 39' West 1201.76 feet; thence # 0° 39' E 270 feet to the place of beginning.

MAY 1 0 2000

NOTE: COPIES OF THIS MAP TO WHICH THE FOLLOWING CERTIFICATE WILL APPLY SHOW SURVEYOR'S ORIGINAL SEAL AND SIGNATURE IN RED INK. COPIES BY ANY OTHER MEANS MAY HAVE ALTERATIONS WHICH DO NOT REPRESENT THE SURVEYOR'S WORK PRODUCT.

I HEREBY CERTIFY THAT THE ABOVE DESCRIBED PROPERTY HAS BEEN SURVEYED UNDER MY DIRECTION AND THAT THE ABOVE MAP IS A TRUE REPRESENTATION THEREOF AND SHOWS THE SIZE AND LOCATION OF THE PROPERTY AND ITS EXTERIOR BOUNDARIES. THIS SURVEY IS MADE FOR THE USE OF THE PRESENT OWNERS OF THE PROPERTY, AND ALSO THOSE WHO PURCHASE, MORTGAGE, OR GUARANTEE THE TITLE THERETO WITHIN ONE YEAR FROM THE DATE HEREOF.

DATED: 3-22-2000

PETER S. GORDÓN R.L.S. 2101

рвојест но. 5536

03/20/2000 SHEET NO. 1 OF 1

MAR 2 2 2000

| 90 80 70 60 <sup>50</sup> 40 30 20 10 | <u>| materialization lingting lingt</u>

MAP SCALE IN FEET ORIGINAL 1" = 30'

18