ABERNATHY and ASSOCIATES

Kenneth B. Abernathy Jr.

Wisconsin Registered Land Surveyor S-1594 Rt. 3, Box 273

Elkhorn, Wisconsin 53121 Phone: (414) 723-4260 (office)

(414) 723-4813 (residence)


PLAT OF SURVEY

Lots 26 and 27 of BLOCK 1 of STARK'S SUBDIVISION located in the Northeast $\frac{1}{4}$ of Section 1, Town 1 North, Range 16 East, Village of Williams Bay, Walworth County, Wisconsin.

ordered by: CENTURY 21 SKANDIA REALTY, INC.

Saute: Sarah E. Gaul

822 E. GENEVA ST. DELAVAN, WI. 53115

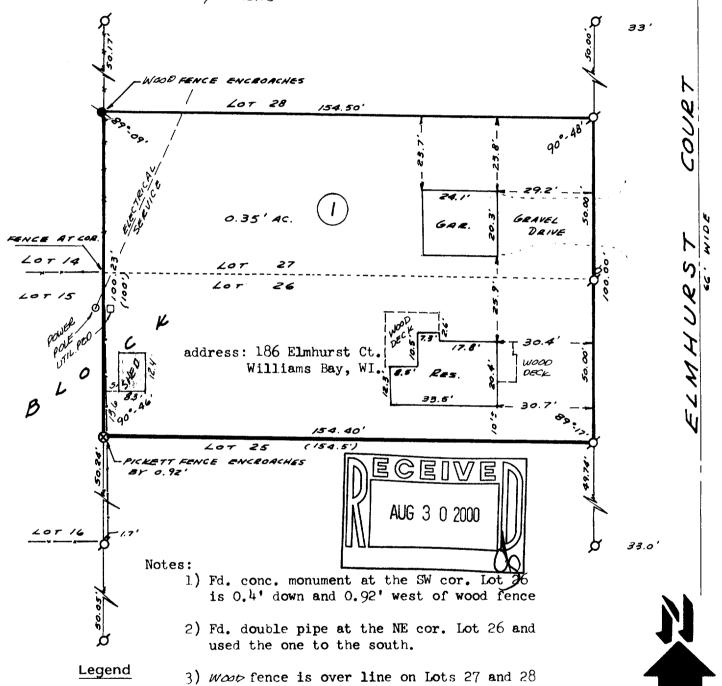

FOUND IRON PIPE FOUND IRON ROD 4) Residence and Gar. are frame structures. SCALE: 111= 30 FEET

FOUND BRASS CAPPED MONUMENT

FOUND CONCRETE MONUMENT

CHISEL CUT IN CONCRETE

SET IRON ROD, 24" LONG, WEIGHING 1.5 LBS./LINEAL FT., 3/4" DIA.

SET IRON ROD, 30" LONG, WEIGHING 4.5 LBS./LINEAL FT., 1-11/16" DIA.

RECORDED AS DIMENSION

BERNATHY. 5-1594

"I hereby certify that I have surveyed the above described property and that the above map is a true representation thereof and shows the size and location of the property, its exterior boundaries, the location of all visible structures and dimensions of all principal buildings thereon, boundary fences, apparent easements, roadways and visible encroachments, if any."

"This survey is made for the use of the present owners of the property, and also those who purchase, mortgage, or guarantee the title thereto within one year from date hereof."

KENNETH B. ABERNATHY, JR. WISCONSIN REGISTERED LAND SURVEYOR,

S-1594

6-18-86 Job No. 608 Date: 5-9-00