

## **ABELL** SURVEYING & MAPPING

1140 SEQUOIA STREET . DELAVAN, WISCONSIN 53115 262-728-6737

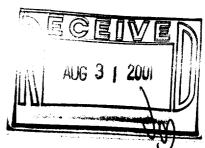

6 6 H H 田 R Ħ

ORCHARD

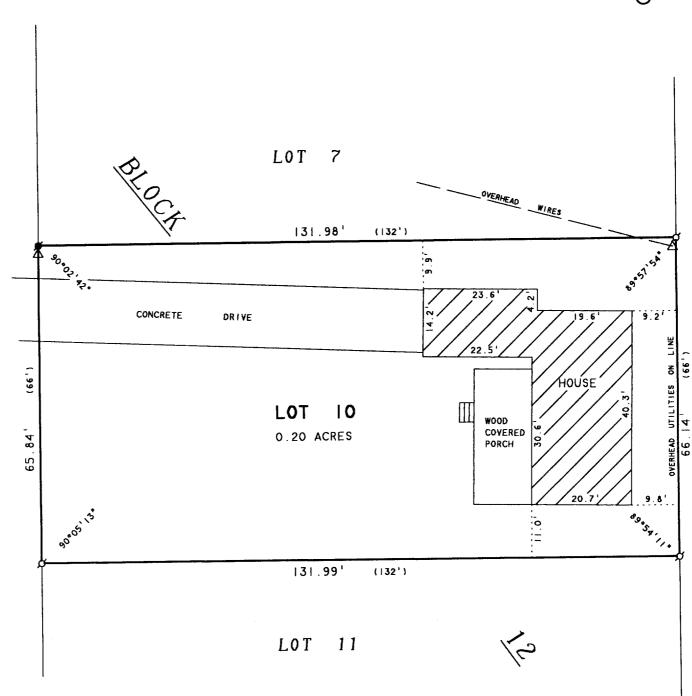

## PLAT OF SURVEY OF

LOT 10. BLOCK 12. WILLIAMS 2ND ADDITION. VILLAGE OF WILLIAMS BAY. WALWORTH COUNTY. WISCONSIN.

ORDERED BY: ATTY. JAMES A. MARINO 5521 N. CUMBERLAND AVE. SUITE 1109

CHICAGO, IL 60656



SCALE | " = 20 ' LEGEND

- IRON PIPE FOUND ✓ - IRON ROD FOUND
△ - UTILITY POLE ( ) - RECORDED AS

I HEREBY CERTIFY THAT I HAVE SURVEYED THE ABOVE DESCRIBED PROPERTY AND THAT THE ABOVE MAP IS A TRUE REPRESENTATION THEREOF AND SHOWS THE SIZE AND LOCATION OF THE PROPERTY, ITS EXTERIOR BOUNDARIES, THE LOCATION OF ALL VISIBLE STRUCTURES AND DIMENSIONS OF ALL PRINCIPAL BUILDINGS THEREON, BOUNDARY FENCES, APPARENT EASEMENTS, ROADWAYS AND VISIBLE ENCROACHMENTS, IF ANY, TO THE BEST OF MY KNOWLEDGE AND BELIEF.

THIS SURVEY IS MADE FOR THE USE OF THE PRESENT OWNERS OF THE PROPERTY, AND ALSO THOSE WHO PURCHASE, MORTGAGE, OR GUARANTEE THE TITLE THERETO WITHIN ONE (1) YEAR FROM DATE HEREON.

DAVID F. ABELL WISCONSIN REGISTERED LAND SURVEYOR. S-1596

April 24, 2001

JOB NUMBER - 01036 NOTE: THIS IS NOT A CERTIFIED COPY UNLESS SEALED.

WOP-180