

## PLAT OF SURVEY

LOT 121 OF CEDAR POINT PARK SECOND ADDITION LOCATED IN THE VILLAGE OF WILLIAMS BAY WALWORTH COUNTY, WISCONSIN

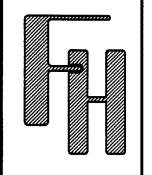

## HIGHLAND ROAD

40' WDF

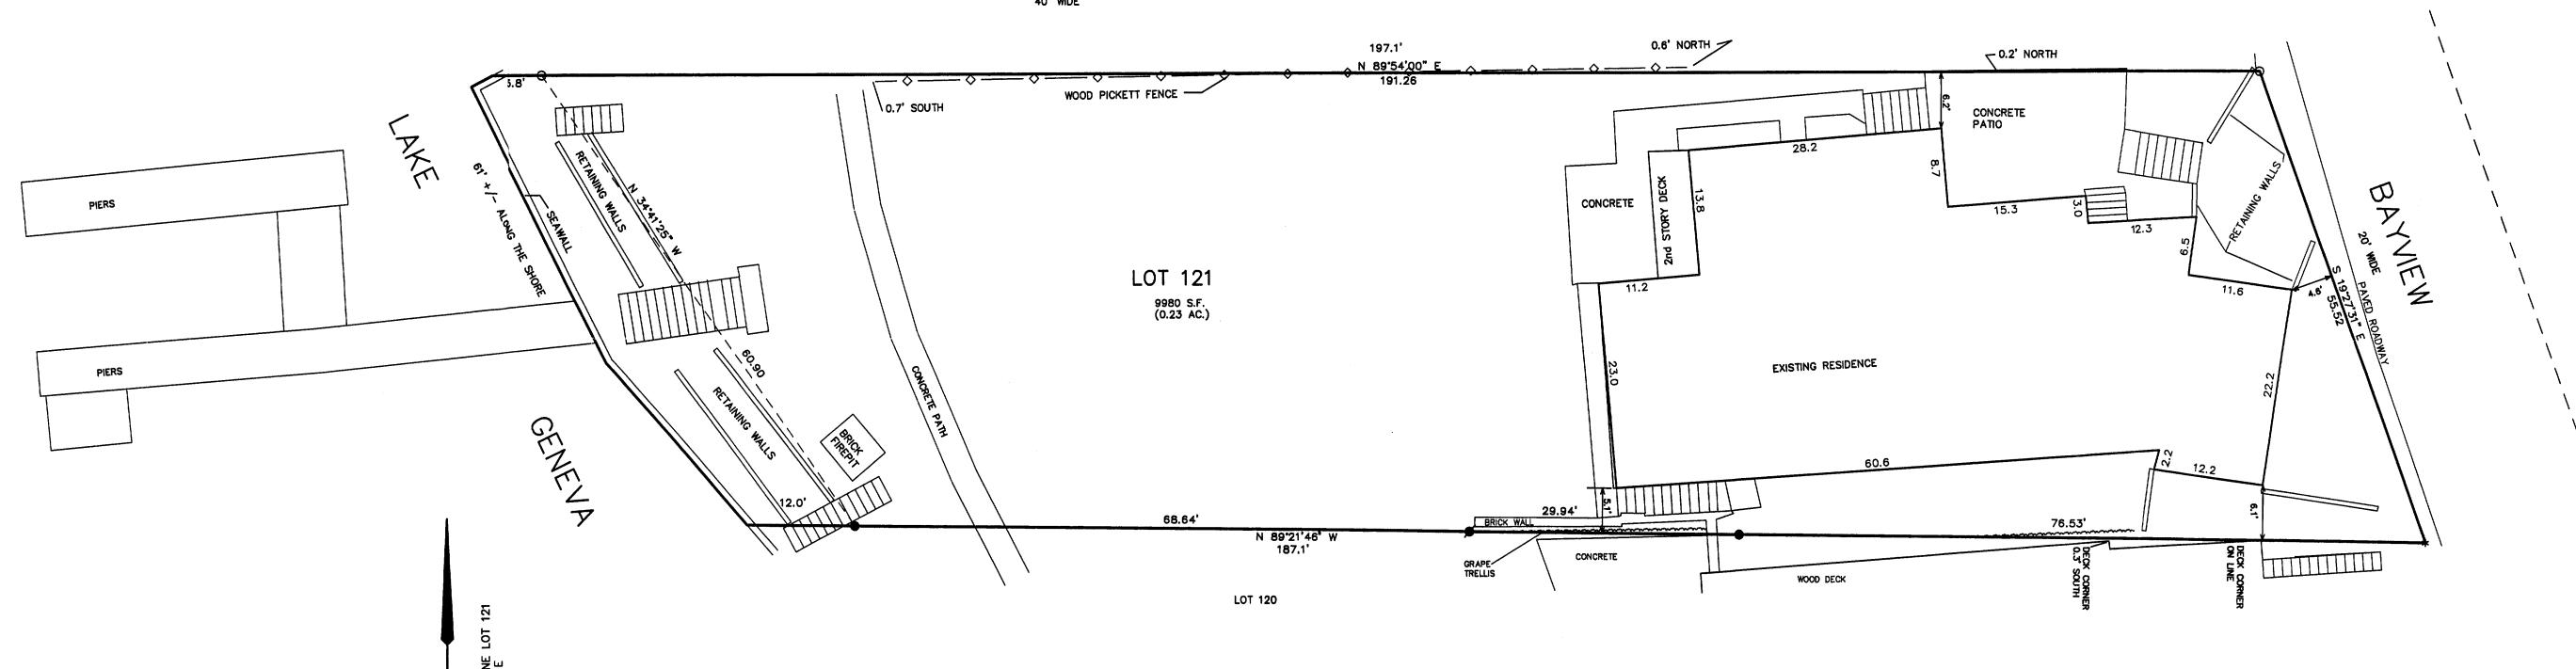

LEGEND

● = FOUND IRON REBAR STAKE

■ = SET IRON REBAR STAKE

O = FOUND IRON PIPE STAKE 1" DIA.

\* = FOUND PK NAIL IN PAVEMENT (XXX) = RECORDED AS SIGNATURE IN RED INK. COPIES BY ANY OTHER MEANS MAY HAVE ALTERATIONS WHICH DO NOT REPRESENT THE SURVEYOR'S WORK PRODUCT.

I HEREBY CERTIFY THAT THE ABOVE DESCRIBED PROPERTY HAS BEEN SURVEYED UNDER MY DIRECTION AND THAT THE ABOVE MAP IS A TRUE REPRESENTATION THEREOF AND SHOWS THE SIZE AND LOCATION OF THE PROPERTY AND ITS EXTERIOR BOUNDARIES. THIS SURVEY IS MADE FOR THE USE OF THE PRESENT OWNERS OF THE PROPERTY, AND ALSO THOSE WHO PURCHASE, MORTGAGE, OR GUARANTEE THE TITLE THERETO WITHIN ONE YEAR FROM THE DATE HEREOF.

DATED: NOV. 9, 2001

NOTE: COPIES OF THIS MAP TO WHICH THE FOLLOWING CERTIFICATE WILL APPLY SHOW SURVEYOR'S ORIGINAL SEAL AND

PETER S. GORDON R.L.S. 2101

NOV 1 4 2001

PROJECT NO.
5921

DATE
11-08-01

SHEET NO.

1 OF 1

REVISIONS

MAP SCALE IN FEET 1" = 10"