
PLAT OF SURVEY -OF-

LOT NUMBERED ONE (1) EXCEPT THE EAST 10 FEET THEREOF, IN BLOCK NUMBERED TWO (2) IN UNIVERSITY HEIGHTS, A SUBDIVISION LOCATED IN THE VILLAGE OF WILLIAMS BAY, ACCORDING TO THE PLAT THEREOF ON RECORD IN THE OFFICE OF THE REGISTER OF DEEDS IN AND FOR SAID WALWORTH COUNTY, WISCONSIN.

SURVEY FOR: TERRY AND LUANN SMITH

NOTE: PROPOSED DWELLING TO BE STAKED UPON NOTIFICATION BY THE ABOVE NAMED CLIEN

DEC 2 0 2001

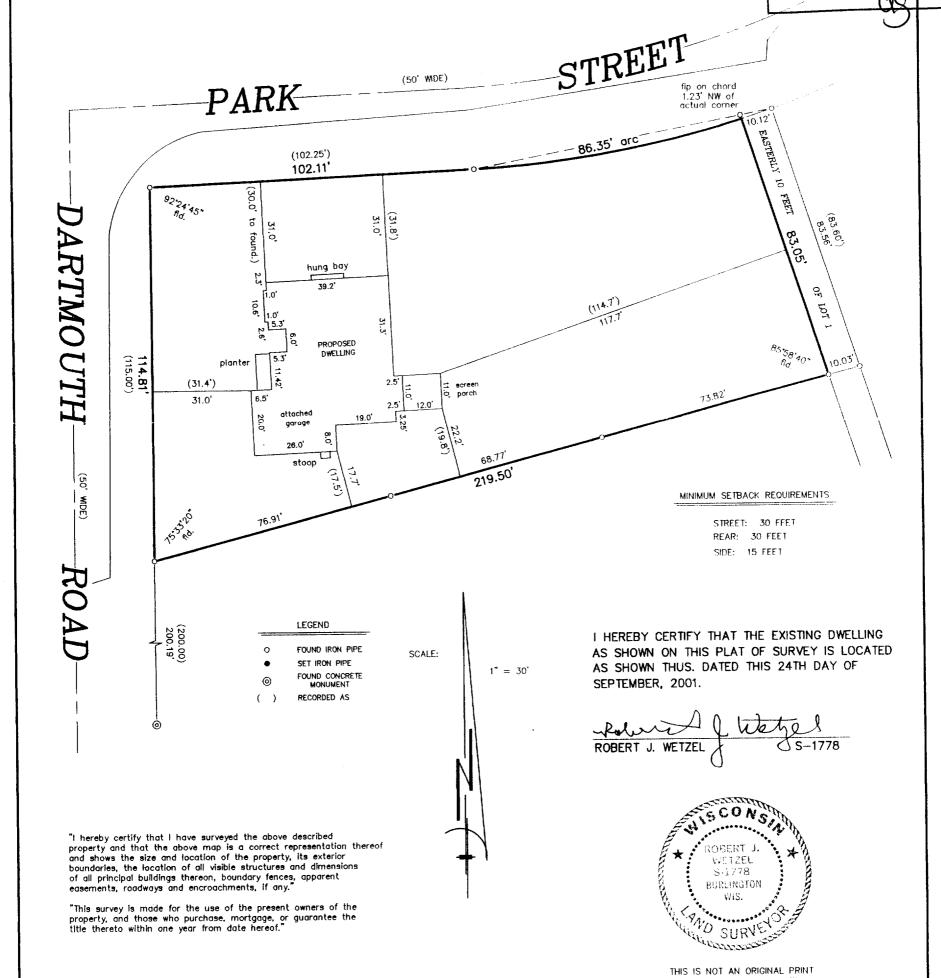



B.W. SURVEYING

LAND SURVEYS
MAPPING AND PLANNING
412 N. PINE STREET
BURLINGTON, WI 53105
(414)-767-0225

ROBERT J. WETZEL S-17

UNLESS THIS SEAL IS RED.

NOVEMBER 1, 2000

DATE

4734 JOB NUMBER

Ø11-1586