


LOT 1, WILLABAY WOODS, Village of Williams Bay, Walworth County, Wisconsin.

Surveyed for: Bielinski Bros. Builders/Salvador and Sandra Laurie

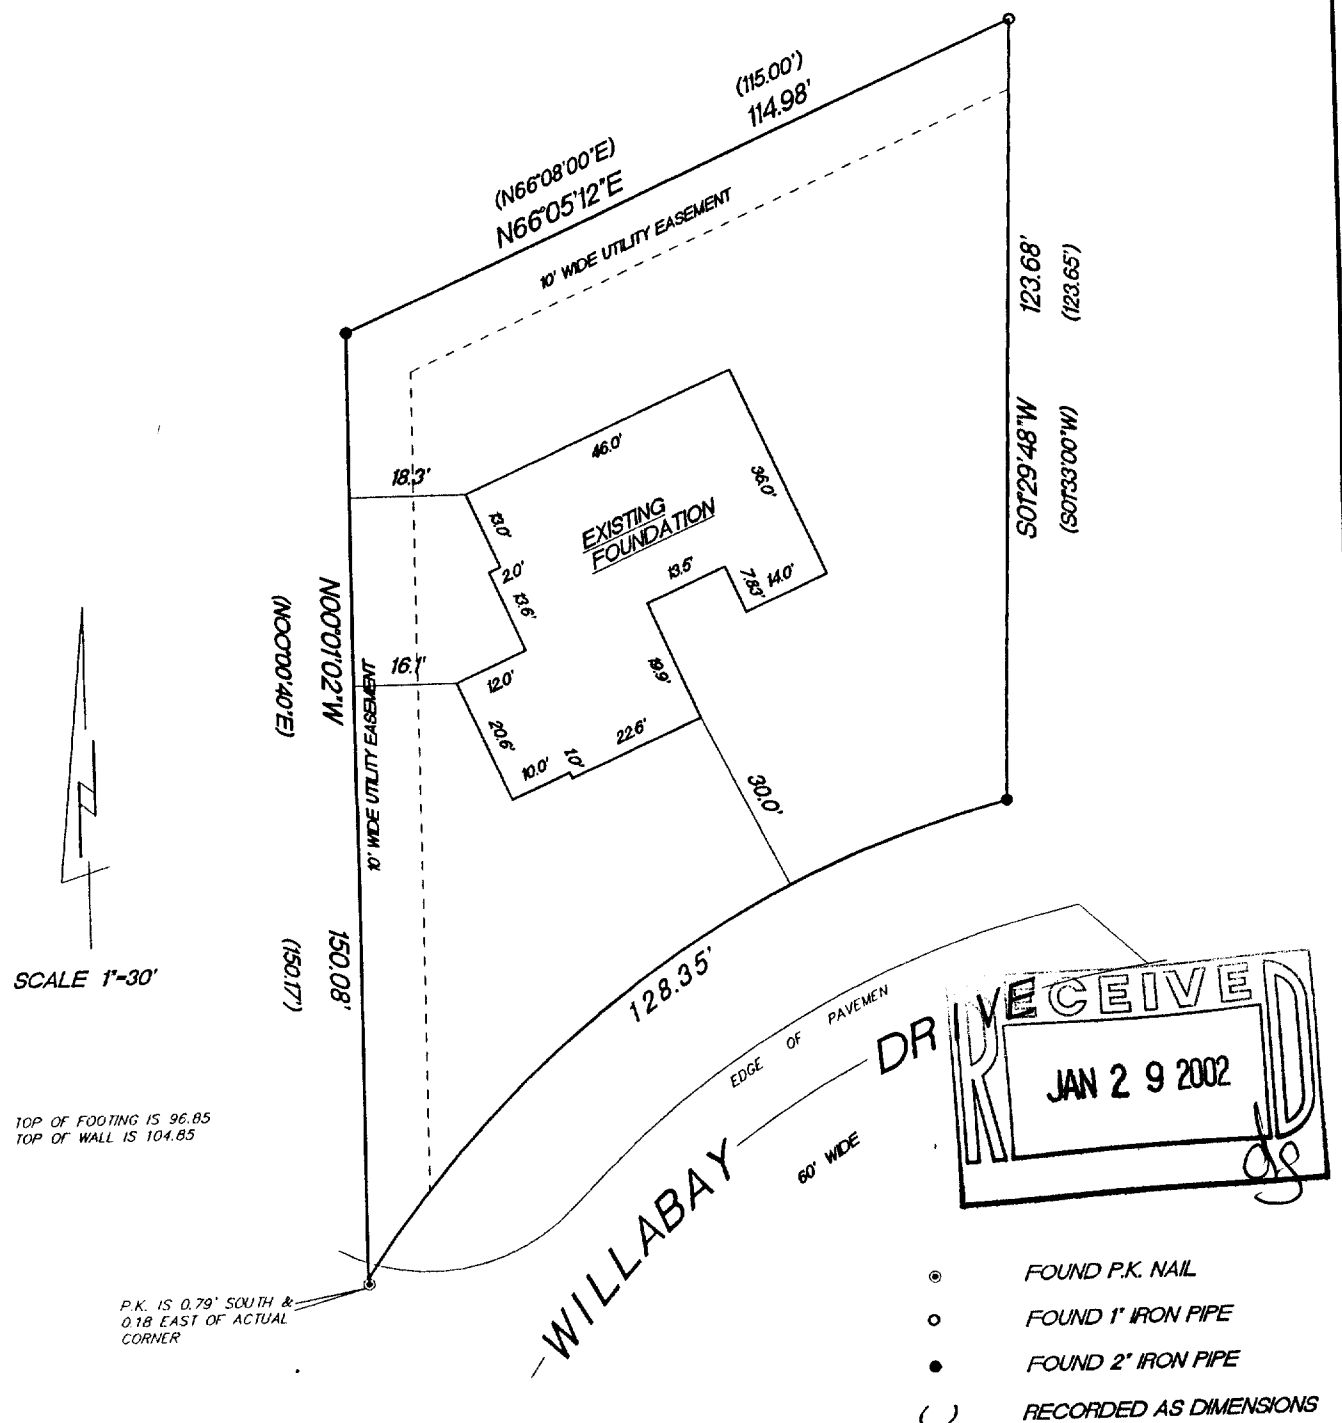

RADIUS	LENGTH	CHORD	BEARING	DELTA
170.00'	128.35'	125.32'	S54°20'48"W	43°15'26"

"This survey is made for the use of the present owners of the property, and also those who purchase, mortgage or guarantee the title thereto within one year from date hereof."

Terrance E. Pisarek R.L.S.

THIS IS NOT AN ORIGINAL SURVEY UNLESS THE SEAL IS RED.

REV. 12/4/01
9/11/01

DATE _____

TEP/DW

FIELD WORK BY

TEP

DRAWN BY

01073

JOB NUMBER

WWW-1

011-1597