FARRIS, HANSEN & ASSOC. INC.


7 RIDGWAY COURT- P.O. BOX 437 ELKHORN, WISCONSIN 53121 PHONE (262) 723-2098 FAX (262) 723-5886


ORDERED BY: SUNRISE HOMES 534 PHEASANT RIDGE LANE FONTANA, WI. 53125

PLAT OF SURVEY

DRIVE

THE SOUTH 30' OF THE WEST 92' OF LOT 2 & THE WEST 92' OF LOT 3 BLOCK 1 OF HARBOR VIEW SUBDIVISION VILLAGE OF WILLIAMS BAY WALWORTH COUNTY, WISCONSIN

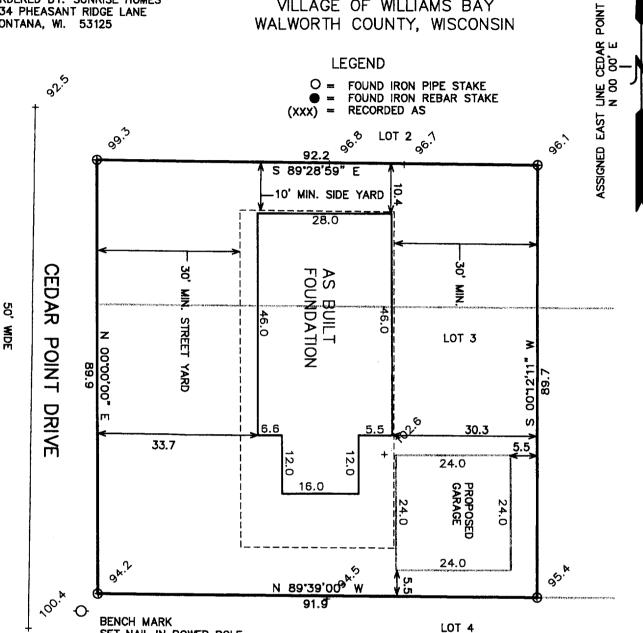

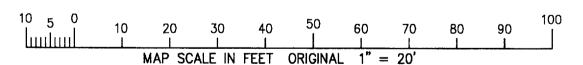

SET NAIL IN POWER POLE EL. ASSIGNED = 105.17'

PROJECT NO. 6136 DATED: 10-09-2002

SHEET 1 OF 1 SHEETS

NOTE: COPIES OF THIS MAP TO WHICH THE FOLLOWING CERTIFICATE WILL APPLY SHOW SURVEYOR'S ORIGINAL SEAL AND SIGNATURE IN RED INK. COPIES BY ANY OTHER MEANS MAY HAVE ALTERATIONS WHICH DO NOT REPRESENT THE SURVEYOR'S WORK

I HEREBY CERTIFY THAT THE ABOVE DESCRIBED PROPERTY HAS HEREBY CERTIFY THAT THE ABOVE DESCRIBED PROPERTY HAS BEEN SURVEYED UNDER MY DIRECTION AND THAT THE ABOVE MAP IS A TRUE REPRESENTATION THEREOF AND SHOWS THE SIZE AND LOCATION OF THE PROPERTY AND ITS EXTERIOR BOUNDARIES. THIS SURVEY IS MADE FOR THE USE OF THE PRESENT OWNERS OF THE PROPERTY, AND ALSO THOSE WHO PURCHASE, MORTGAGE, OR GUARANTEE THE TITLE THERETO WITHIN ONE YEAR FROM THE DATE HEREOF

DATED: OCT. 2002

REVISED 11-12-2002 TO SHOW SIZE & LOCATION OF FOUNDATION AS BUILT

M

PETER S. GORDON R.L.S. 2101

CEIIV NOV 2 | 2002

WHV-ZA