
## DUNHAM SURVEYING, S. C SURVEYING & SUBDIVIDING DELAYAN, WISCONSIN 53H5

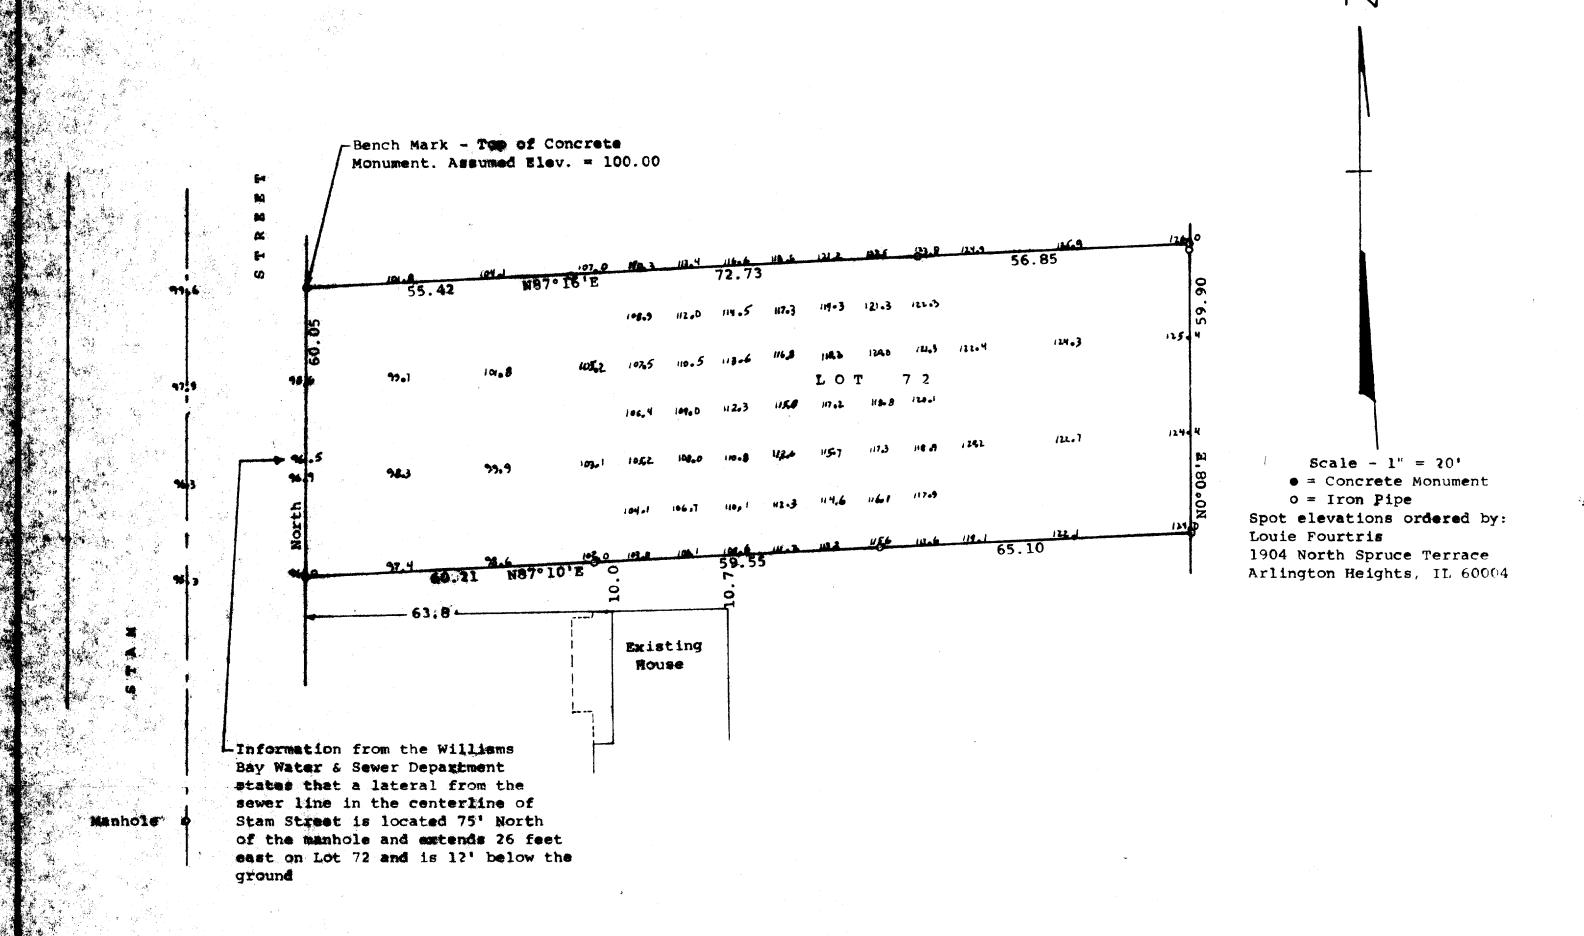

Plat of survey of Lot 72, Bay View Subdivision, located in the Village of Williams Bay, Walworth County, Wisconsin, together with spot elevations on said lot February 4 and 9, 2000

George T. Dunham, Surveyor



