




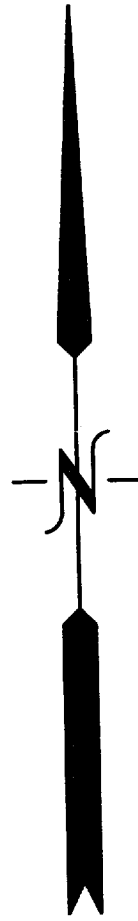

ADDENDUM TO PLAT OF SURVEY
 PREPARED BY B.W. SURVEYING
 DATED 03-29-2000
 TO SHOW AS BUILT
 ADDITION FOUNDATION

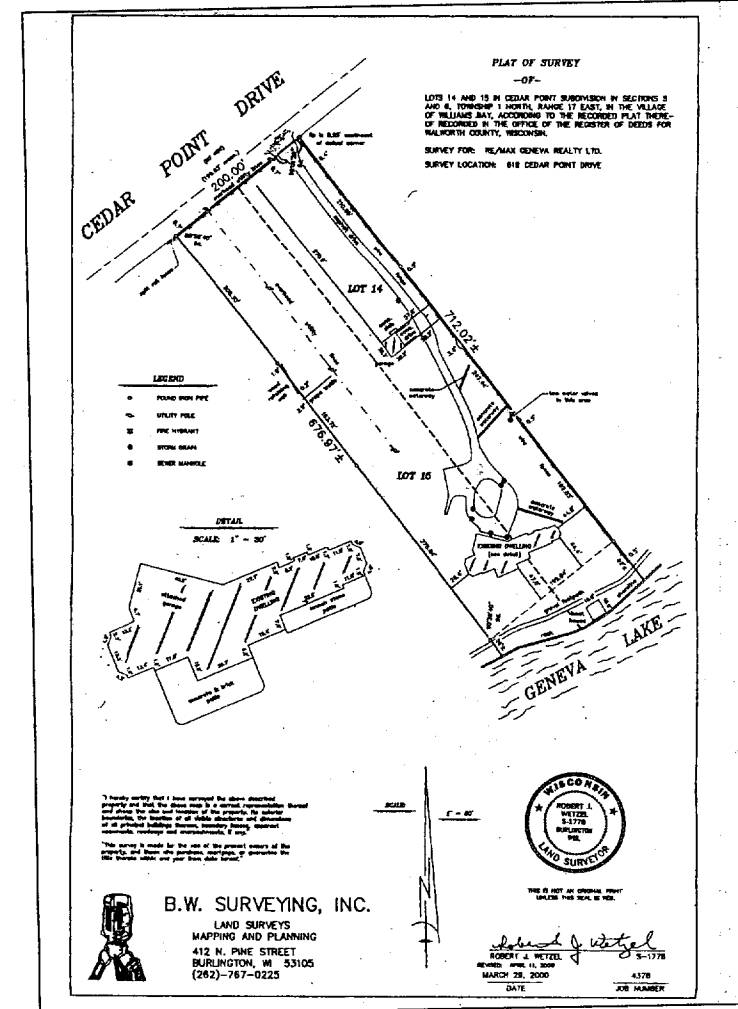

217.68' (217.73')

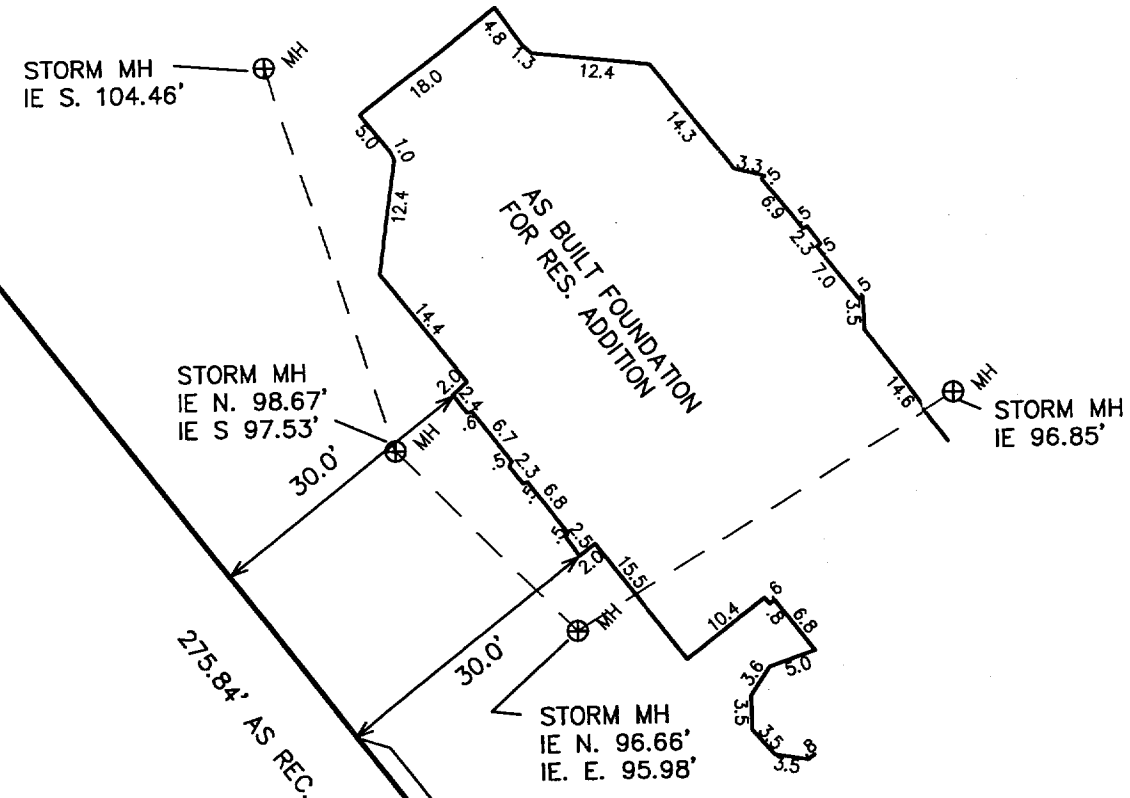


NOTE: COPIES OF THIS MAP TO WHICH THE FOLLOWING CERTIFICATE WILL APPLY SHOW SURVEYOR'S ORIGINAL SEAL AND SIGNATURE IN RED INK. COPIES BY ANY OTHER MEANS MAY HAVE ALTERATIONS WHICH DO NOT REPRESENT THE SURVEYOR'S WORK PRODUCT.

I HEREBY CERTIFY THAT THIS MAP IS A TRUE AND ACCURATE REPRESENTATION OF THE LOCATION OF THE AS BUILT ADDITION FOUNDATION IN RELATION TO THE MONUMENTS FOUND AND SHOWN REPRESENTING POINTS ON THE SOUTHEAST AND NORTHEAST PROPERTY LINES TO THE BEST OF MY PROFESSIONAL KNOWLEDGE AND BELIEF. NOTE THIS IS NOT A PLAT OF SURVEY AS DEFINED IN CHAPTER A-E 7 OF WISCONSIN ADMINISTRATIVE CODE

DATED: JUNE 24, 2003

Peter S. Gordon
 PETER S. GORDON RLS 2101

JUL 30 2003
 kw

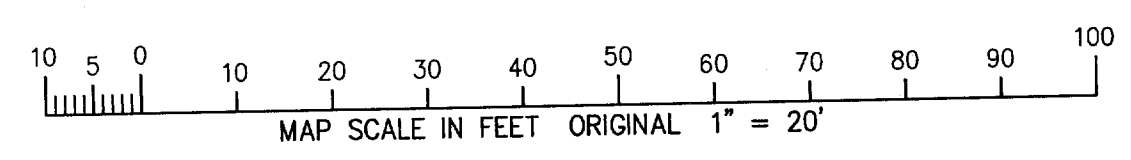

6/24/2003 X:\Projects\6264\DCAD\ASBLT

WCPH-8

011-1754

WORK ORDERED BY: FRANK GUIDO
 5625 CRANBERRY ROAD
 BURLINGTON, WI.

FARRIS, HANSEN & ASSOCIATES, INC.
 ENGINEERING - ARCHITECTURE - SURVEYING
 7 RIDGWAY COURT P.O. BOX 437
 ELKHORN, WISCONSIN 53121
 OFFICE: (262) 723-2088 FAX: (262) 723-5886

REVISIONS

PROJECT NO. 6264
 DATE: 06-24-03
 SHEET NO. 1 OF 1