
PREPARED FOR: RODNEY WHETLOW KEEFE REALTY 751 GENEVA PARKWAY LAKE GENEVA WI 53147


PLAT OF SURVEY

J.K. SURVEYING INC. N3705 WILLOWBEND LANE LAKE GENEVA, WI, 53147 262-248-3697

- OF -

LOT 36, IN SUMMER HAVEN ON LAKE GENEVA ACORDING TO THE PLAT THEREOF IN THE VILLAGE OF WILLIAMS BAY, RECORDED IN THE OFFICE OF REGISTERED DEEDS FOR WALWORTH COUNTY, WISCONSIN MAY FOURTH, 1927 IN VOLUME 9 OF PLATS AT PAGES 78 AND 79.

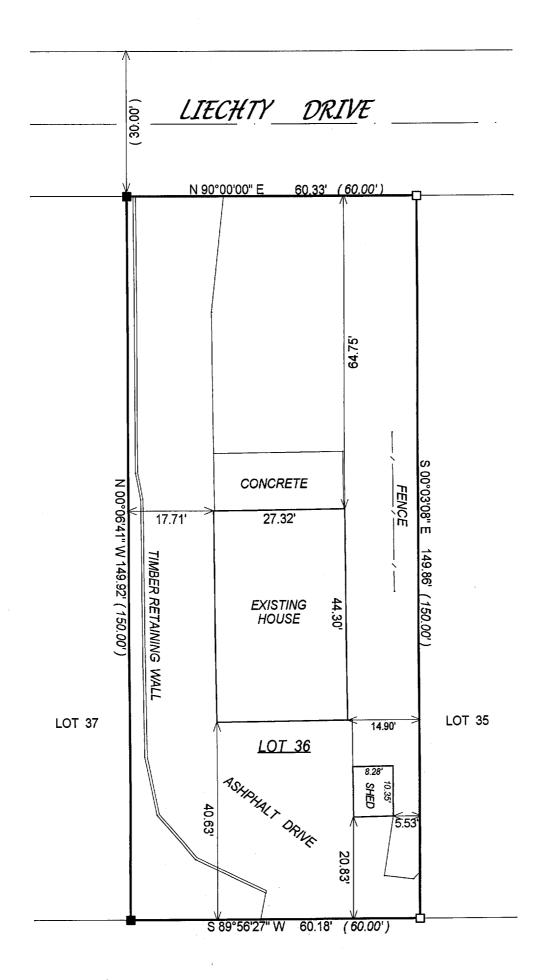

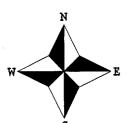

()= recorded as

□ = found iron bar

= found iron pipe

= set iron pipe

= set iron bar

SCALE 1" = 20'

JOB #03-602

TAX ID # WSU00032

MT - 3 -

QQ Q

NOTE: BEARINGS ARE ASSUMED.

COMPARE LEGAL DESCRIPTION ABOVE AND DRAWING WITH DEED. FOR BUILDING RESTRICTIONS AND EASEMENTS NOT SHOWN, REFER TO DEED, ABSTRACT SOURCES AND LOCAL MUNICIPAL CODES. NOTIFY THE SURVEYOR IMMEDIATELY OF ANY DISCREPANCY.

"I hereby certify that I have surveyed the above described property and that the above map is a true representation thereof and shows the size and location of all visible structures, apparent easements and encroachments if any."

This survey is made for the present owners of the property, and those who purchase, mortgage, or guarantee the title thereto, within one year from the date hereof.



JOHN KROTT S - 2258
Wisconsin Registered Land Surveyor

(original if signed in red)

DATED THIS THE 26th DAY OF SEPTEMBER 2003.