
REVISED 11-19-2003 TO SHOW SIZE & LOCATION OF PROPOSED RESIDENCE

REVISED 01-06-2004 TO SHOW SIZE & LOCATION OF AS-BUILT FOUNDATION

PLAT OF SURVEY LOT 12 OF BLOCK 6 LAKEWOOD TRAILS SUBDIVISION

LOCATED IN THE NE 1/4 AND THE NW 1/4 OF THE NW 1/4 OF SECTION 1, TOWN 1 NORTH, RANGE 16 EAST, VILLAGE OF WILLIAMS BAY, WALWORTH COUNTY, WISCONSIN

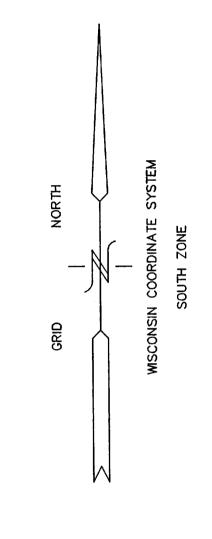

O = FOUND IRON PIPE STAKE 1" DIA.

● = FOUND IRON REBAR STAKE 3/4"

■ = FOUND CONCRETE COUNTY MONUMENT

# = FOUND SOLID ROUND IRON BAR STAKE 1 5/16"

(XXX) = RECORDED AS

NOTE: GENERAL EASEMENT IS A COMBINATION OF UTILITY, DRAINAGE, AND WALKWAY EASEMENTS.

NOTE: COPIES OF THIS MAP TO WHICH THE FOLLOWING CERTIFICATE WILL APPLY SHOW SURVEYOR'S ORIGINAL SEAL AND SIGNATURE IN RED INK. COPIES BY ANY OTHER MEANS MAY HAVE ALTERATIONS WHICH DO NOT REPRESENT THE SURVEYOR'S WORK PRODUCT.

I HEREBY CERTIFY THAT THE ABOVE DESCRIBED PROPERTY HAS BEEN SURVEYED UNDER MY DIRECTION AND THAT THE ABOVE MAP IS A TRUE REPRESENTATION THEREOF AND SHOWS THE SIZE AND LOCATION OF THE PROPERTY AND ITS EXTERIOR BOUNDARIES. THIS SURVEY IS MADE FOR THE USE OF THE PRESENT OWNERS OF THE PROPERTY, AND ALSO THOSE WHO PURCHASE, MORTGAGE, OR GUARANTEE THE TITLE THERETO WITHIN ONE YEAR FROM THE DATE HEREOF.

DATED: JUNE 6, 2002

PETER S. GORDON R.L.S. 2101

PROJECT NO. 3836.06.12 DATE: 05/24/02 SHEET NO.

1 OF 1

WLAK-102

FAIR OAKS DRIVE

S 87'-12'22" W 99.95 R=967.00 ARC=100.00

-30' STREET YARD

AS-BUILT

FOUDATION FIELD LOCATED 1/05/2004

-30' REAR YARD

s 89'-30'-21"W

MAP SCALE IN FEET ORIGINAL 1" = 20'

12 12,770 S.F.

11

N 2 8

DRB

SCONS

PETER S.

GORDON

S-2101

ELKHOPIN,

-12' GENERAL EASEMENT CENTERED ON LOT LINE