


PLAT OF SURVEY

-OF-


LOT 32 AND THE NORTH 1/2 OF LOT 33, FIRST ADDITION TO CEDAR POINT PARK, BEING A SUBDIVISION OF PART OF THE SOUTHEAST 1/4 OF SECTION 6, TOWN 1 NORTH, RANGE 17 EAST, ACCORDING TO THE PLAT THEREOF ON RECORD IN THE OFFICE OF THE REGISTER OF DEEDS IN AND FOR SAID COUNTY. THE PROPERTY HEREBY CONVEYED IN LOT 33 IS FURTHER DESCRIBED AS BEING ALL OF SAID LOT 33 LYING NORTH OF AN IMAGINARY STRAIGHT LINE WHICH SHALL COMMENCE EQUIDISTANT FROM THE EAST OR REAR LOT STAKES OF SAID LOT 33 AND CONTINUE IN A STRAIGHT LINE IN A WESTERLY DIRECTION TO THE WATER'S EDGE, INTERSECTING THE PRINCIPAL MERIDIAN SHOWN ON THE RECORDED PLAT OF FIRST ADDITION TO CEDAR POINT PARK AS ABOVE MENTIONED, EQUIDISTANT FROM THE LOT STAKES OF SAID LOT 33 WHICH ARE SHOWN WHERE THE PRINCIPAL MERIDIAN INTERSECTS THE NORTH AND SOUTH LOT LINE OF SAID LOT 33, SAID LAND BEING IN THE VILLAGE OF WILLIAMS BAY, COUNTY OF WALWORTH, AND STATE OF WISCONSIN.

SURVEY FOR: PHILLIP CAROLLO
SURVEY LOCATION: 112 BIRCH WALNUT DRIVE

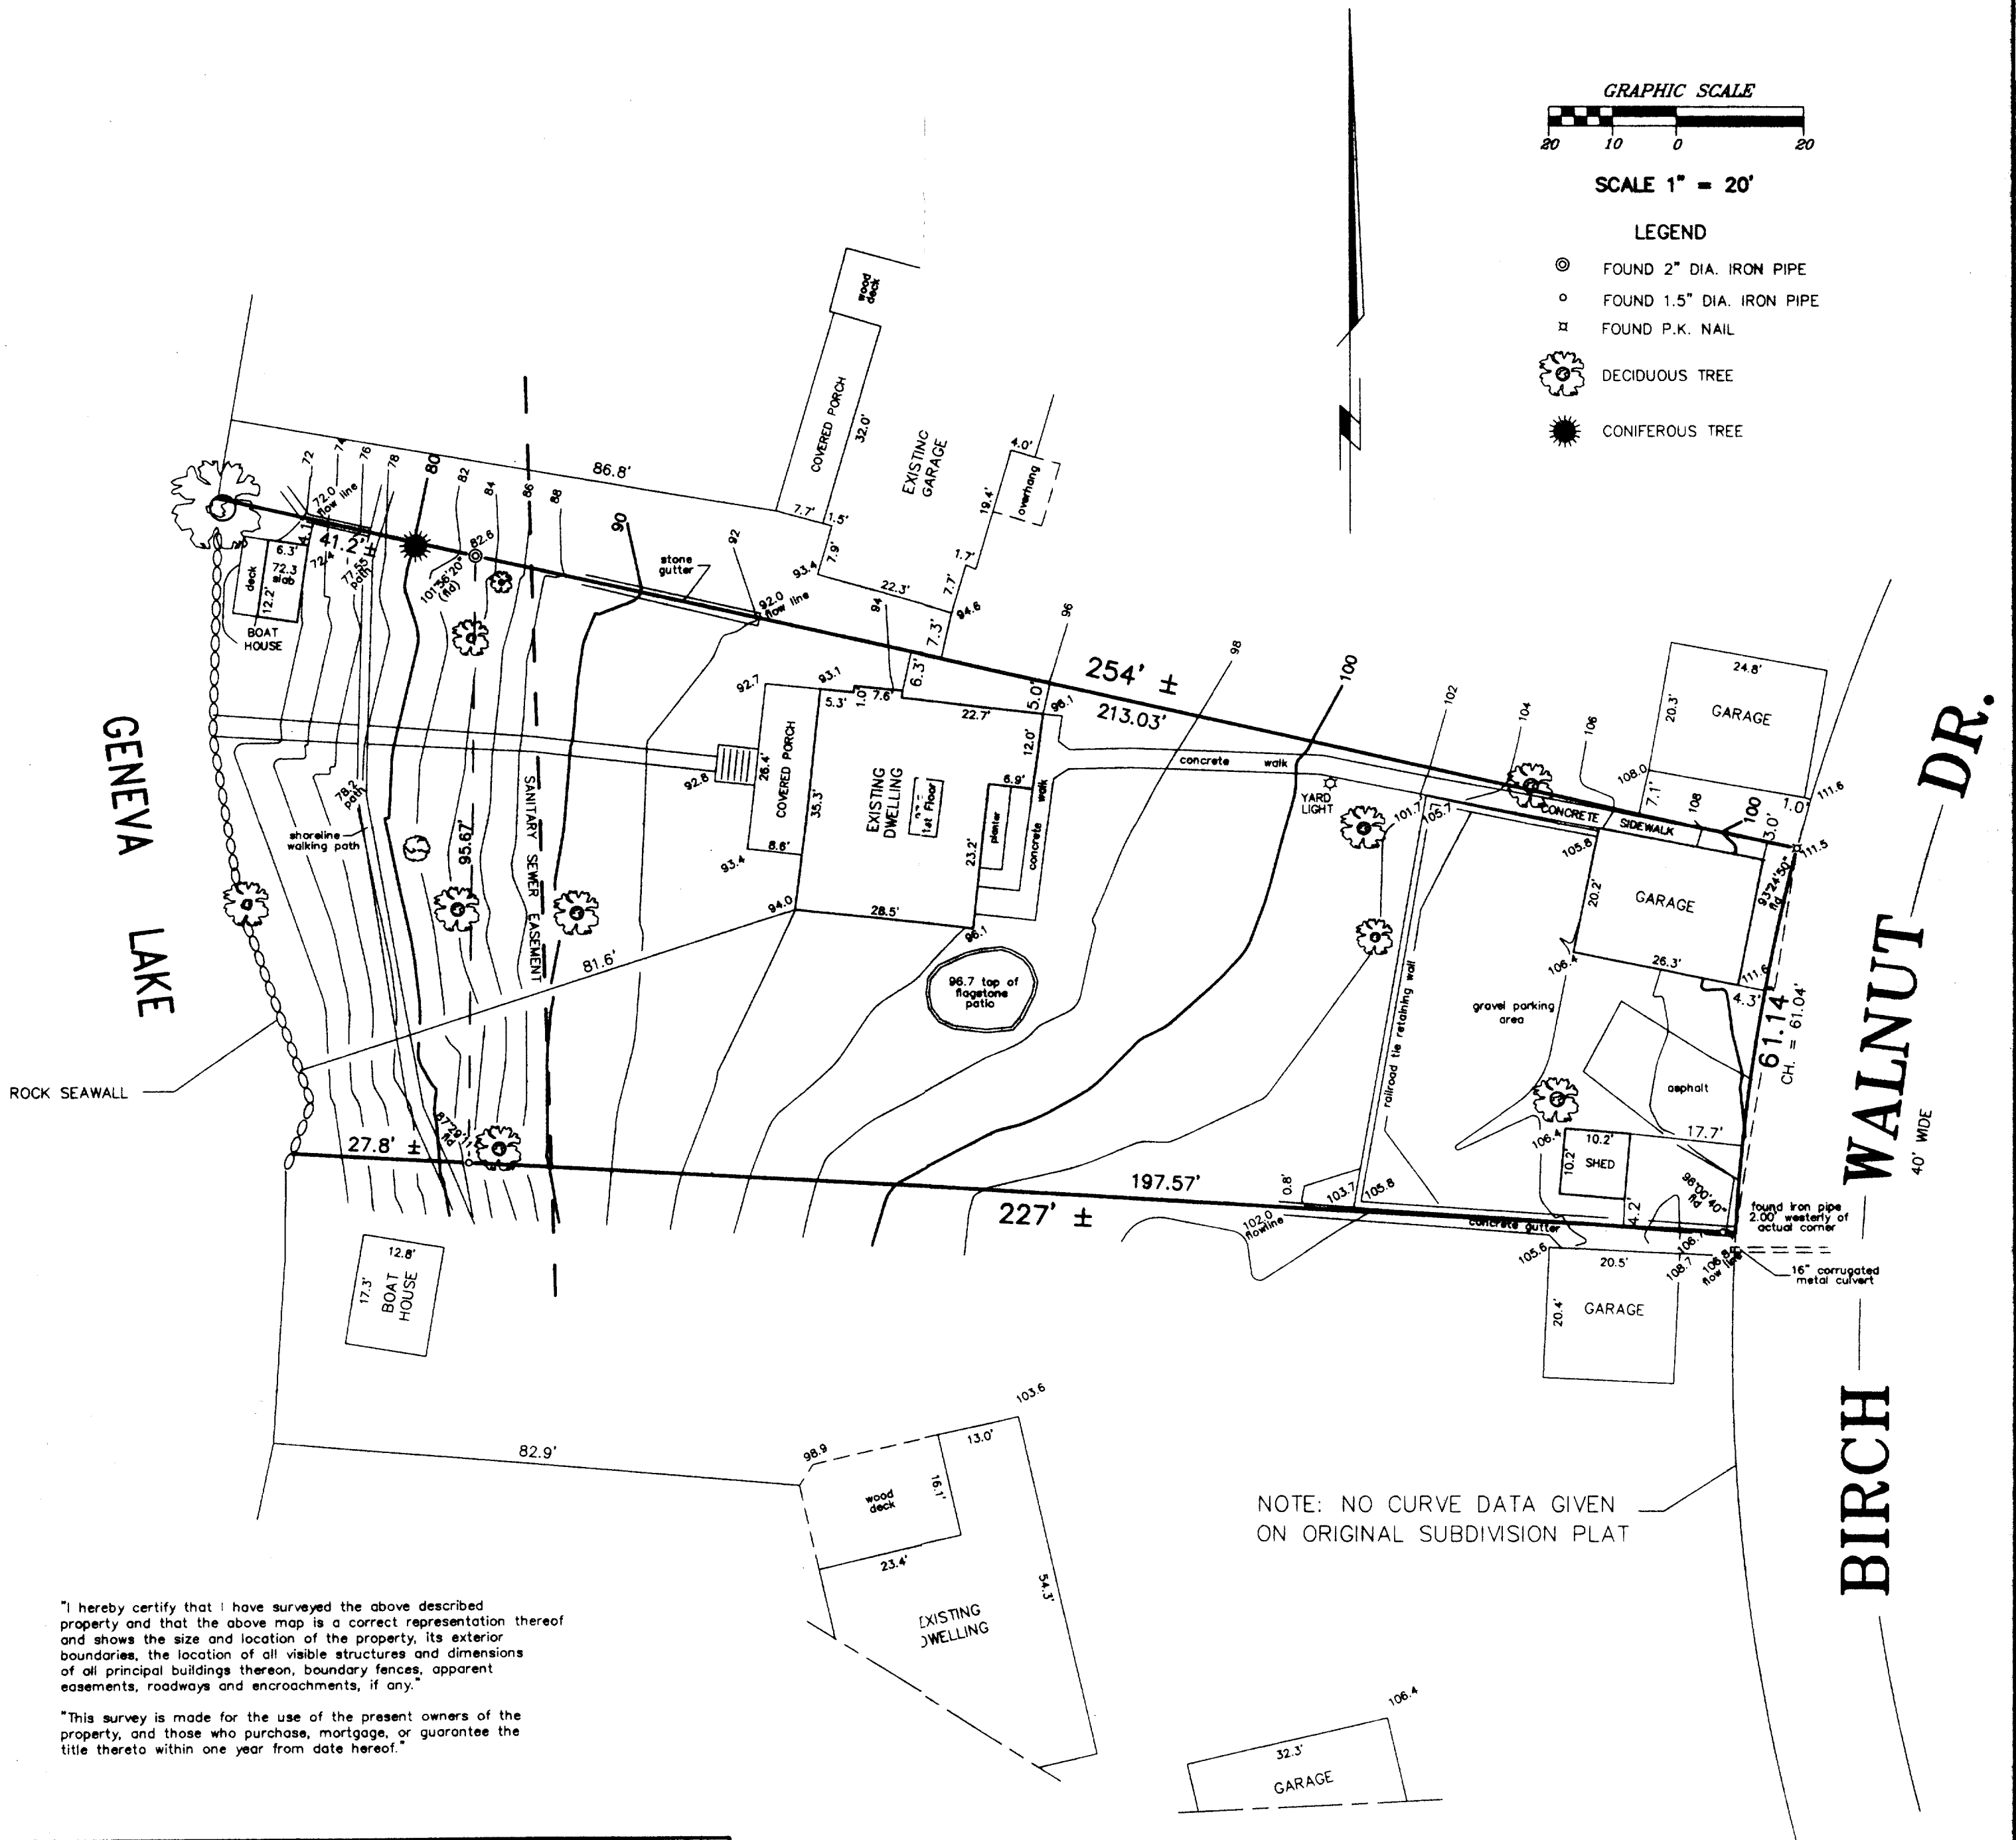

"I hereby certify that I have surveyed the above described property and that the above map is a correct representation thereof and shows the size and location of the property, its exterior boundaries, the location of all visible structures and dimensions of all principal buildings thereon, boundary fences, apparent easements, roadways and encroachments, if any."

"This survey is made for the use of the present owners of the property, and those who purchase, mortgage, or guarantee the title thereto within one year from date hereof."

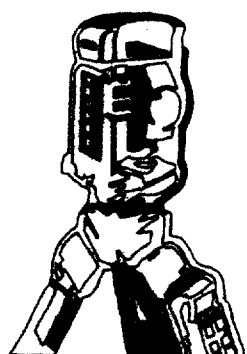


B.W. SURVEYING, INC.

412 N. PINE STREET
BURLINGTON, WI 53105
(262)-767-0225



Franklin J. Lehman
FRANKLIN J. LEHMAN S-2211

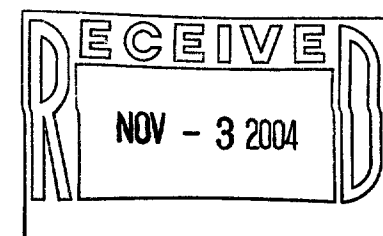

DRAWN BY: FJL	DATE: SEPT. 10, 2004
CHECKED BY:	DRAWING NO.: 6550
JOB NO.: 6550	SHEET 1 OF 1