
Plat of Survey


Lot 8 of Jewell's Subdivision,


located in the Southeast 1/4 of Section 1, Town 1 North, Range 16 East, Village of Williams Bay, Walworth County, Wisconsin.

Surveyed for:

Century 21 Affiliated 50 West Geneva Street * P.O. Box 367 Williams Bay, Wisconsin. 53191

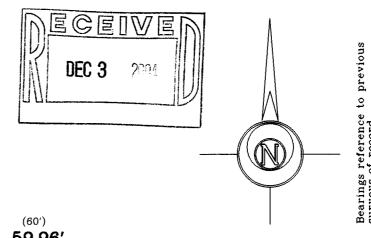

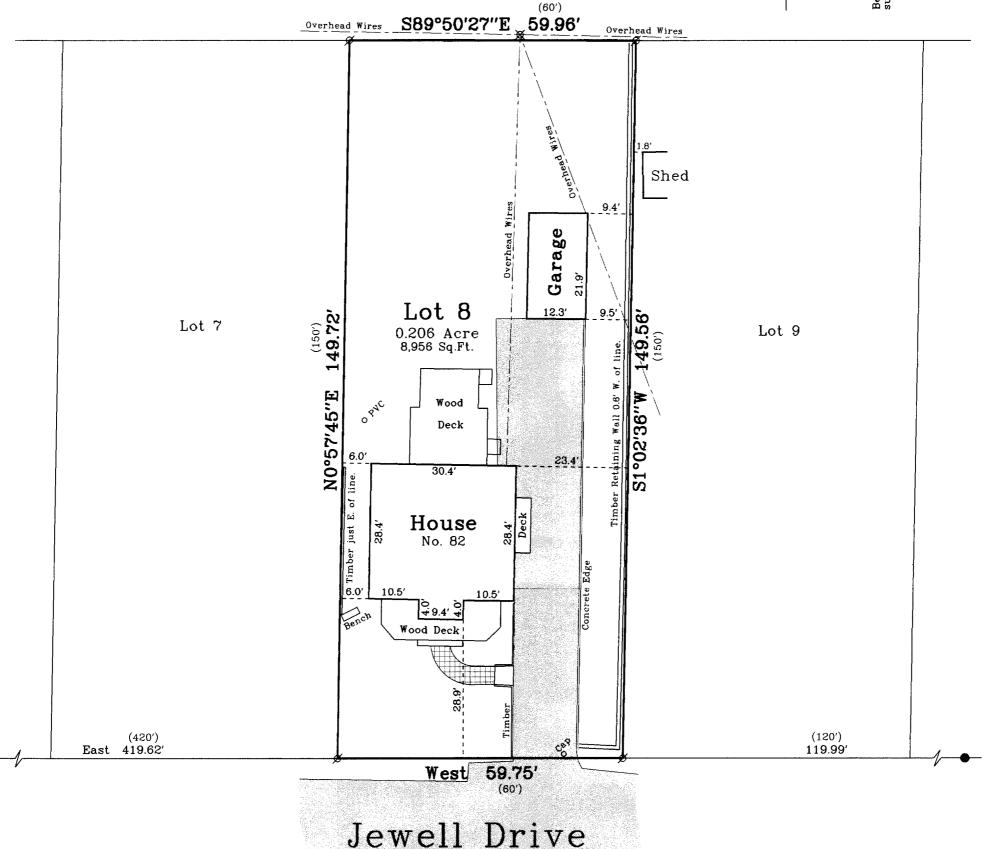

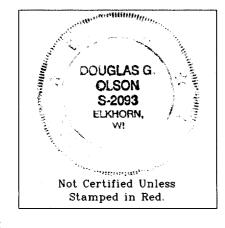

Notes:

- 1) This survey plat is not certified unless signed and sealed in red ink.
- 2) This survey is subject to Wisconsin lien laws. This Plat of Survey is the notice of intent to file lien. Lien waiver required.

Copyright c 2004 by Jensen & Olson Land Surveying, LLC.

(30' Wide)

All rights reserved. No part of this survey plat may be reproduced or transmitted in any form by any means — graphic, electronic, or mechanical, including photocopying, tracing, or information storage and retrieval systems — without permission in writing from Douglas G. Olson, Jensen & Olson Land Surveying, LLC.

I hereby certify that I have surveyed the above described property and the map hereon is correct to the best of my professional knowledge and belief and shows the size and location of the property, its exterior boundaries, the location and dimensions of all visible structures thereon, boundary fences, apparent easements and roadways and visible encreachments if may

and visible encroachments, if any.

This survey is made for the exclusive use of the present owners of property, and also those who purchase, mortgage or guarantee title thereto, within one year from the date hereof.

60' 011-1863

Douglas G Olson Wisconsin Registered Land Surveyor - 2093

Legend

- Ø Found Iron Pipe Found Iron Rod () Recorded Information
- _≋_Utility Pole Asphalt Surface

Brick Walk

Jensen & Olson Land Surveying, LLC

45 South Wisconsin Street P.O. Box 322

Telephone: (262) 723-3434 Facsimile: (262) 723-8044

Scale: 1'' = 20'

40

Survey date: October 11, 2004. Revisions:

Elkhorn, Wisconsin. 53121

20

Sheet 1 of 1 Sheets.

Job Reference Number:

2004.158

WJ-7