## PLAT OF SURVEY -OF-


LOT 101 IN BLOCK 1 IN LAKEWOOD TRAILS NORTH SUBDIVISION, LOCATED IN THE NORTHWEST 1/4 AND THE NORTHEAST 1/4 OF THE NORTHWEST 1/4 OF SECTION 1, IN TOWNSHIP 1 NORTH, RANGE 16 EAST, IN THE VILLAGE OF WILLIAMS BAY, COUNTY OF WALWORTH, STATE OF WISCONSIN.

THEATRE

ROAD

SURVEY FOR: PLAN IT DESIGN

SURVEY LOCATION: 428 FAIR OAKS DRIVE

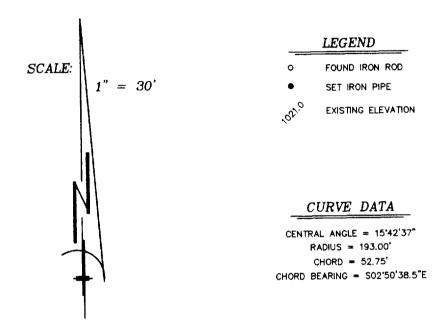

"I hereby certify that I have surveyed the above described property and that the above map is a correct representation thereof and shows the size and location of the property, its exterior boundaries, the location of all visible structures and dimensions of all principal buildings thereon, boundary fences, apparent easements, roadways and encroachments, if any."

"This survey is made for the use of the present owners of the property, and those who purchase, mortgage, or guarantee the title thereto within one year from date hereof."



B.W. SURVEYING, INC.

LAND SURVEYS
MAPPING AND PLANNING
412 N. PINE STREET
BURLINGTON, WI 53105
(262)-767-0225

I HEREBY CERTIFY THAT THE EXISTING FOUNDATION SHOWN ON THIS PLAT OF SURVEY IS LOCATED AS SHOWN THUS ( ), DATED THIS 22ND DAY OF SEPTEMBER, 2004. EXISTING TOP OF FOUNDATION: 1023.3' MANHOLE RIM ELEVATION = 1022.2' S84°59'21"E 160.66 ō, EXISTING 45 FOUNDATION (61.0') attached 27.5 32.5' BURLINGTON THIS IS NOT AN ORIGINAL PRINT UNLESS THIS SEAL IS RED. 6376 AUGUST 30, 2004 JOB NUMBER DATE