

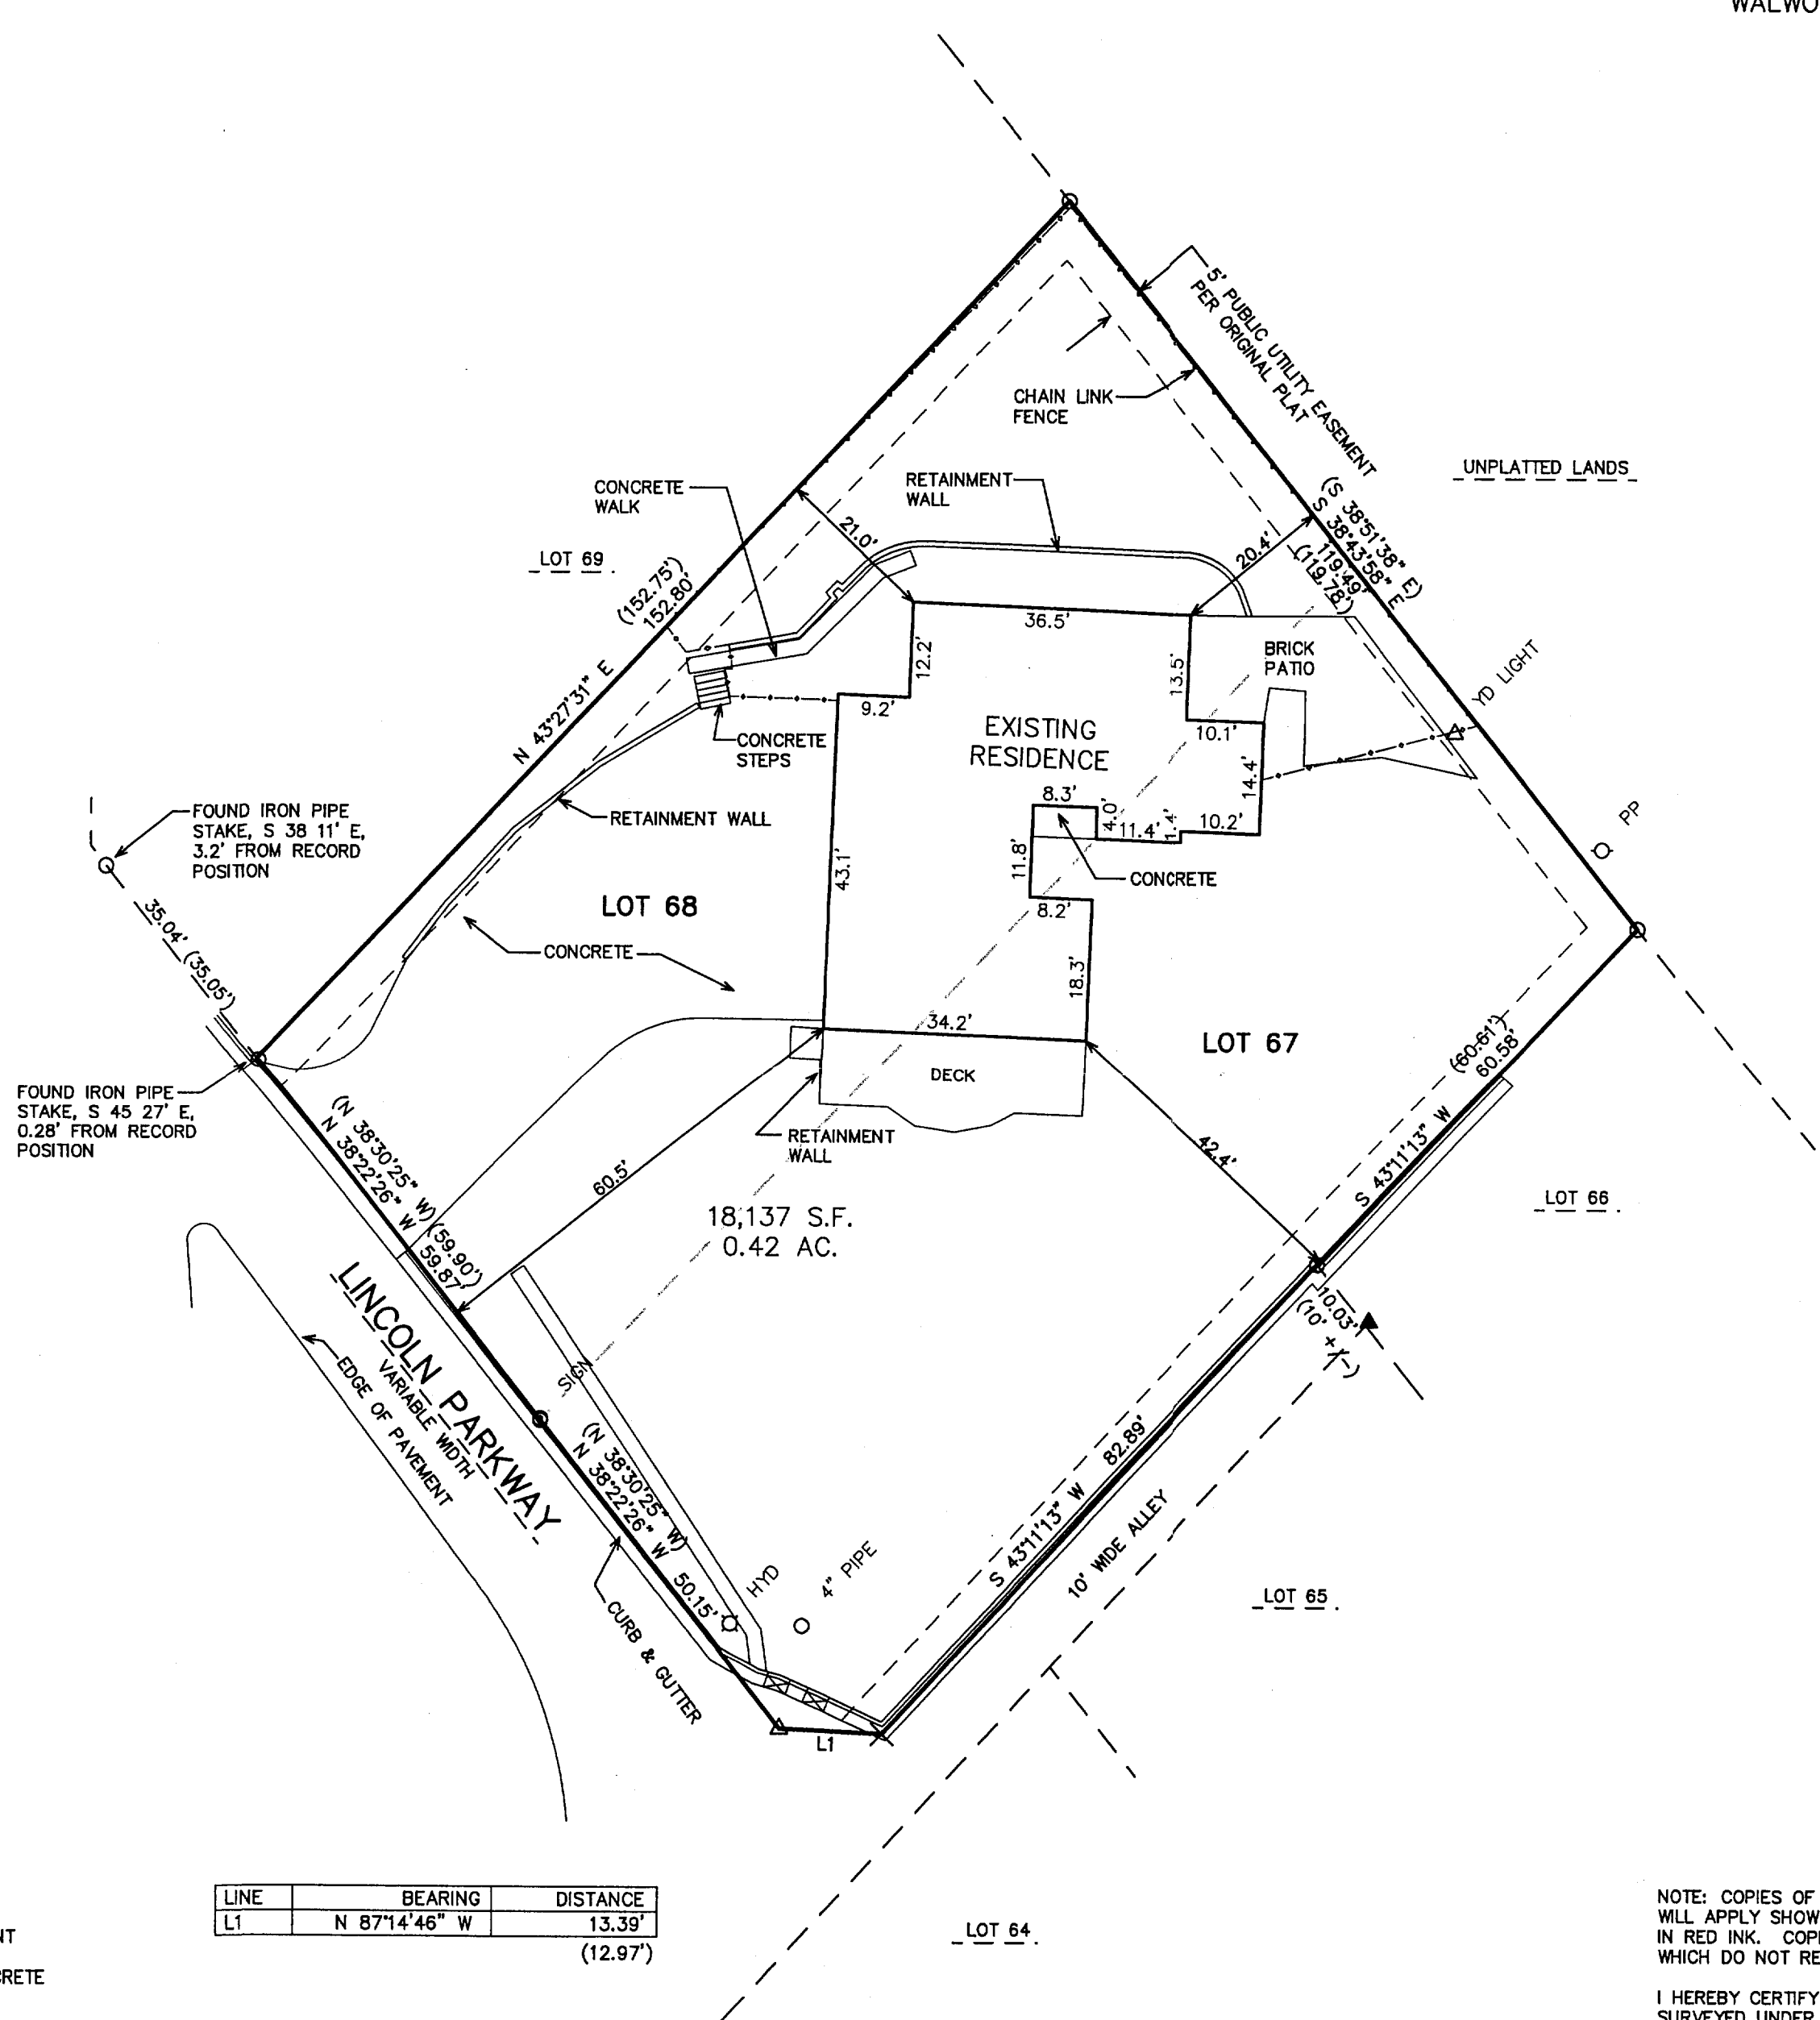
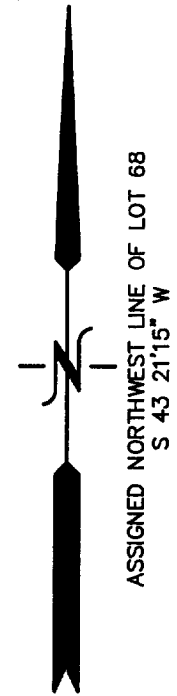


PLAT OF SURVEY
 LOT 67 AND 68 OF THE ORIGINAL PLAT
 OF CEDAR POINT PARK
 LOCATED IN THE VILLAGE OF WILLIAMS BAY,
 WALWORTH COUNTY, WISCONSIN

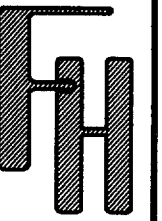

- LEGEND
- = FOUND IRON PIPE STAKE
 - △ = SET "PK" NAIL IN PAVEMENT
 - × = SET CHISELED "X" IN CONCRETE
 - (xxx) = RECORDED AS

LINE	BEARING	DISTANCE
L1	N 87°14'46" W	13.39'
		(12.97')

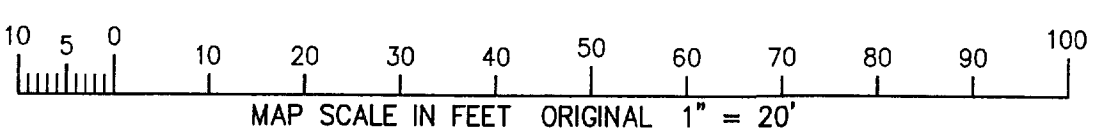


NOTE: COPIES OF THIS MAP TO WHICH THE FOLLOWING CERTIFICATE WILL APPLY SHOW THE SURVEYOR'S ORIGINAL SEAL AND SIGNATURE IN RED INK. COPIES BY ANY OTHER MEANS MAY HAVE ALTERATIONS WHICH DO NOT REPRESENT THE SURVEYOR'S WORK PRODUCT.

I HEREBY CERTIFY THAT THE ABOVE DESCRIBED PROPERTY HAS BEEN SURVEYED UNDER MY DIRECTION AND THAT THE ABOVE MAP IS A TRUE REPRESENTATION THEREOF AND SHOWS THE SIZE AND LOCATION OF THE PROPERTY AND ITS EXTERIOR BOUNDARIES. THIS SURVEY IS MADE FOR THE USE OF THE PRESENT OWNERS OF THE PROPERTY, AND ALSO THOSE WHO PURCHASE, MORTGAGE, OR GUARANTEE THE TITLE THERETO WITHIN ONE YEAR FROM THE DATE HEREOF.

DATED: DECEMBER 1, 2004

Peter S. Gordon
 PETER S. GORDON R.L.S. 2101

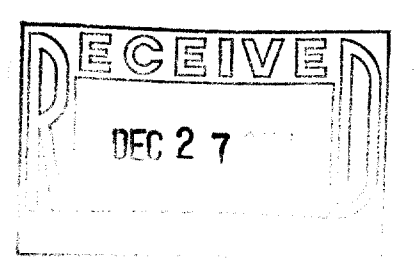

WORK ORDERED BY --
 JOHN FRAUENHOFFER
 3002 CROSSING COURT
 CHAMPAIGN, IL 61822

FARRIS, HANSEN & ASSOCIATES, INC.
 ENGINEERING - ARCHITECTURE - SURVEYING
 7 RIDGWAY COURT P.O. BOX 437
 ELKHORN, WISCONSIN 53121
 OFFICE: (262) 723-2098 FAX: (262) 723-5886

REVISIONS

PROJECT NO.
 6664
 DATE:
 12/01/2004
 SHEET NO.
 1 OF 1

DEC 0 2 2004

X:\Projects\6664\Drawn\SURVEY

WCP-53

011-1867