PREPARED FOR: TOM JOHNSON


PO. BOX 736 WILLIAMS BAY WI. 53191


PLAT OF SURVEY

J.K. SURVEYING INC. N3705 WILLOWBEND LANE LAKE GENEVA, WI, 53147 262-248-3697

- OF -

LOT J IN LOCH VISTA CLUB SUBDIVISION NUMBER 2, WHICH LOT IS DESCRIBED AS FOLLOWS: COMMENCING AT A POINT 425.5 FEET EAST, OF A POINT 10 CHAINS NORTH OF THE SOUTHWEST CORNER OF THE EAST 1/2, OF THE SOUTHEAST 1/4 OF SECTION 1, TOWN 1 NORTH, RANGE 16 EAST; THENCE SOUTH 105 FEET; THENCE EAST 50 FEET; THENCE NORTH 105 FEET; THENCE WEST 50 FEET TO THE PLACE OF BEGINNING, SITUATED IN THE VILLAGE OF WILLIAMS BAY, WALWORTH COUNTY, WISCONSIN.

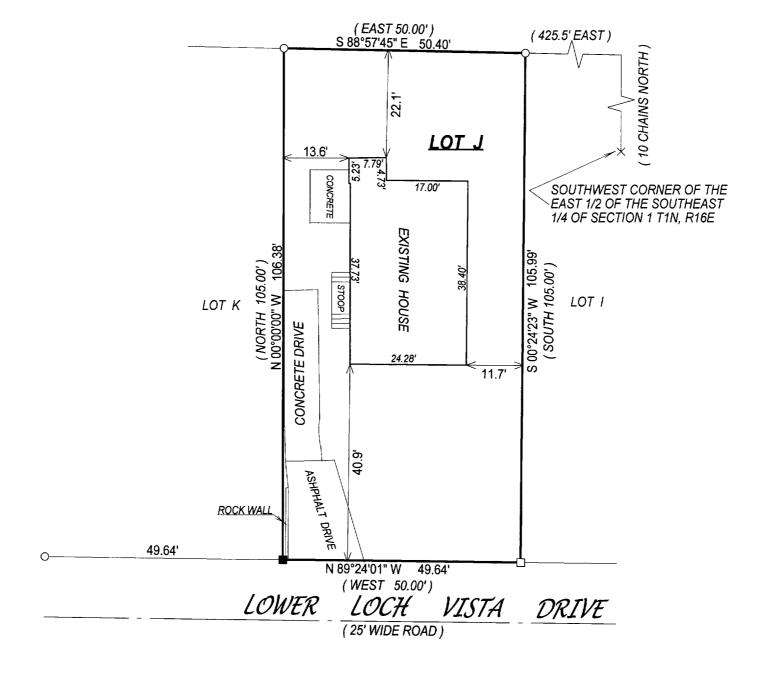

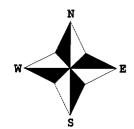

()= recorded as

□ = found iron bar

= found iron pipe

= set iron pipe

= set iron bar

SCALE 1" = 20'


JOB # 04-500

TAX ID # WLV200009

COMPARE LEGAL DESCRIPTION ABOVE AND DRAWING WITH DEED. FOR BUILDING RESTRICTIONS AND EASEMENTS NOT SHOWN, REFER TO DEED, ABSTRACT SOURCES AND LOCAL MUNICIPAL CODES. NOTIFY THE SURVEYOR IMMEDIATELY OF ANY DISCREPANCY.

"I hereby certify that I have surveyed the above described property and that the above map, to the best of my knowledge and belief, is a true representation thereof and shows the size and location of all visible structures, apparent easements and encroachmentsif any."

This survey is made for the present owners of the property, and those who purchase, mortgage, or guarentee the title thereto, within one year from the date hereof.

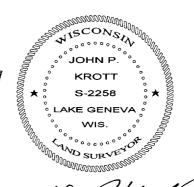

JOHN KROTT S - 2258
Wisconsin Registered Land Surveyor
(original if signed in red)

DATED THIS THE 9th DAY OF SEPTEMBER 2004