

Plat of Survey

of

Lot 2 of Certified Survey Map No. 3799,

recorded in Vol. 23 of Certified Survey Maps of Walworth County on Page 49 and located in the Southeast 1/4 of Section 1, Town 1 North, Range 16 East, Village of Williams Bay, Walworth County, Wisconsin.


Survey for: **Don Wubs**
 P.O. Box 631
 Williams Bay, Wisconsin. 53191

Tax Parcel
 WWUP 00050

Tax Parcel
 WWUP 00051A


Tax Parcel
 WWUP 00051C1

Tax Parcel
 WWUP 00054

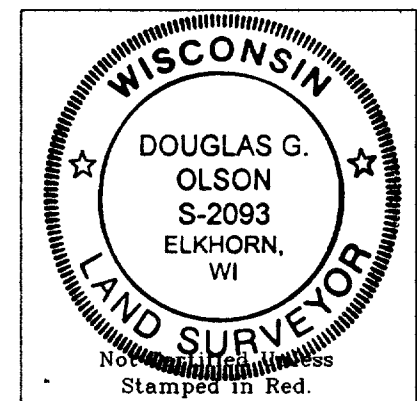


Center 1/4 Corner
 Section 1-1-16.
 N. 212,908.54
 E. 2,390,396.78

East 1/4 Corner
 Section 1-1-16.
 N. 213,030.88
 E. 2,393,062.28

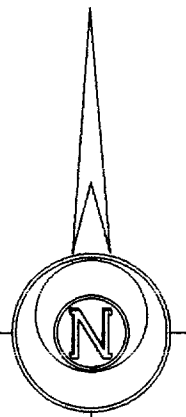

Bearings reference to the Wisconsin State Plane Coordinate System, South Zone.

Survey Date: June 6, 2005.
 Revisions:

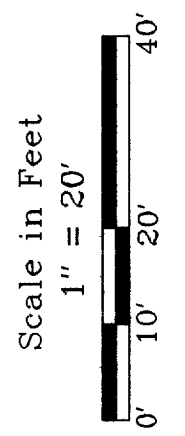

Jensen & Olson Land Surveying, LLC
 45 South Wisconsin Street P.O. Box 322
 Elkhorn, Wisconsin 53121
 Telephone (262) 723-3434
 Facsimile (262) 723-8044

- Legend
- Found County Section Corner
 - Found Concrete Monument
 - Found Iron Pipe
 - Found Iron Rod
 - Set Iron rod, 3/4" dia.
 - Recorded Information
 - ⊗ Asphalt Surface
 - ⊘ Concrete

Sheet 1 of 1 Sheets
 Job Reference Number
2004.100
 2004.100

- Notes:
- 1) This survey plat is not certified unless signed and sealed in red ink.
 - 2) This survey is subject to Wisconsin lien laws. This Plat of Survey is the notice of intent to file lien. Lien waiver required.

Copyright © 2005 by Jensen & Olson Land Surveying, LLC.
 All rights reserved. No part of this survey plat may be reproduced or transmitted in any form by any means - graphic, electronic, or mechanical, including photocopying, tracing, or information storage and retrieval systems - without permission in writing from Douglas G. Olson, Jensen & Olson Land Surveying, LLC.

I hereby certify that I have surveyed the above described property and the map hereon is correct to the best of my professional knowledge and belief and shows the size and location of the property, its exterior boundaries, the location and dimensions of all visible structures thereon, boundary fences, apparent easements and roadways and visible encroachments, if any.
 This survey is made for the exclusive use of the present owners of property and also those who purchase, mortgage or guarantee title thereto, within one year from the date hereof.

Douglas G. Olson
 Wisconsin Registered Land Surveyor - 2093

011-2004

WA 37990002