## ABELL SURVEYING & MAPPING

1140 SEQUOIA STREET . DELAVAN. WISCONSIN 53115 262-728-6737


ROGERS

PARKWAY

ORDERED BY: MIKE HUGHES

1517 W. ADAMS STREET

CHICAGO, IL 60607

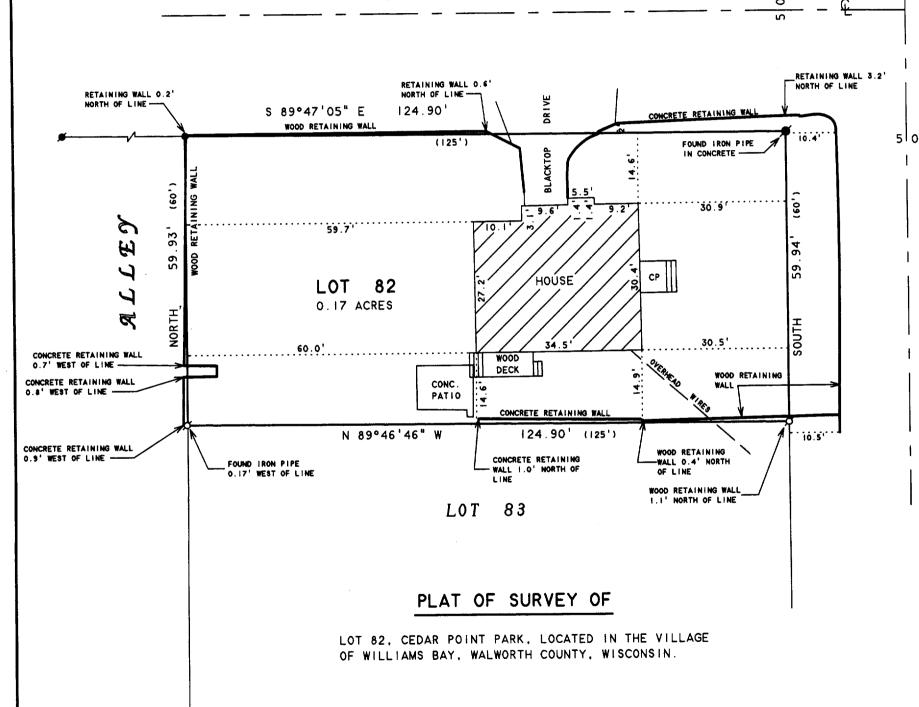

NOTE: THE EAST LINE OF LOT 82 IS ASSUMED NORTH-SOUTH





SCALE | "-20'

LEGEND

Ø - IRON PIPE FOUND # - IRON ROD FOUND CP - CONCRETE PORCH - IRON ROD SET ( ) - RECORDED AS

I HEREBY CERTIFY THAT I HAVE SURVEYED THE ABOVE DESCRIBED PROPERTY AND THAT THE ABOVE MAP IS A TRUE REPRESENTATION THEREOF AND SHOWS THE SIZE AND LOCATION OF THE PROPERTY, ITS EXTERIOR BOUNDARIES, THE LOCATION OF ALL VISIBLE STRUCTURES AND DIMENSIONS OF ALL PRINCIPAL BUILDINGS THEREON, BOUNDARY FENCES, APPARENT EASEMENTS, ROADWAYS AND VISIBLE ENCROACHMENTS, IF ANY, TO THE BEST OF MY KNOWLEDGE AND BELIEF.

THIS SURVEY IS MADE FOR THE USE OF THE PRESENT OWNERS OF THE PROPERTY, AND ALSO THOSE WHO PURCHASE, MORTGAGE, OR GUARANTEE THE TITLE THERETO WITHIN ONE (1) YEAR FROM DATE HEREON.

X

0

DAVID F. ABELL WISCONSIN REGISTERED LAND SURVEYOR, S-1596

2005

JOB NUMBER - 05133 NOTE: THIS IS NOT A CERTIFIED COPY UNLESS SEALED.