

ABELL  
SURVEYING & MAPPING

1140 SEQUOIA STREET • DELAVAN, WISCONSIN 53115  
262-728-6737

N



SCALE 1"=10'

LEGEND

- IRON PIPE FOUND
- ROUND IRON ROD FOUND
- SQUARE IRON ROD FOUND
- IRON BAR FOUND
- WOOD FENCE
- WOOD BOARD FENCE
- YARD LIGHT
- UTILITY POLE
- GUY WIRE
- ( )-RECORDED AS

GENEVA

STREET

LOT 1  
AREA 0.32 ACRES

STREET

66 FEET WIDE


WILLIAMS

TAX PARCEL WWUP-32



PLAT OF SURVEY OF

LOT 1, BLOCK 5 OF THE ORIGINAL PLAT OF THE VILLAGE  
OF WILLIAMS BAY, WALWORTH COUNTY, WISCONSIN.

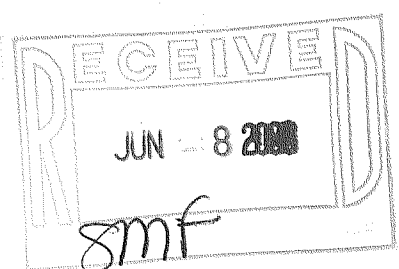

ORDERED BY: ATTY. LOUIS SCHERB  
234 WAUKEGAN ROAD  
GLENVIEW, IL 60025

I HEREBY CERTIFY THAT I HAVE SURVEYED THE ABOVE DESCRIBED PROPERTY AND THAT THE ABOVE MAP IS A TRUE REPRESENTATION THEREOF AND SHOWS THE SIZE AND LOCATION OF THE PROPERTY, ITS EXTERIOR BOUNDARIES, THE LOCATION OF ALL VISIBLE STRUCTURES AND DIMENSIONS OF ALL PRINCIPAL BUILDINGS THEREON, BOUNDARY FENCES, APPARENT EASEMENTS, ROADWAYS AND VISIBLE ENCROACHMENTS, IF ANY, TO THE BEST OF MY KNOWLEDGE AND BELIEF.

THIS SURVEY IS MADE FOR THE USE OF THE PRESENT OWNERS OF THE PROPERTY, AND ALSO THOSE WHO PURCHASE, MORTGAGE, OR GUARANTEE THE TITLE THERETO WITHIN ONE (1) YEAR FROM DATE HEREON.

David F. Abell  
DAVID F. ABELL  
WISCONSIN REGISTERED LAND SURVEYOR, S-1596

March 13, 2006

DATE  
NOTE: THIS IS NOT A CERTIFIED COPY UNLESS SEALED.

JOB NUMBER - 06017

WOP-68

11-2049