PREPARED FOR: MARKED CONSTRUCTION

SCALE: 1" = 30'

JOB #: 06-244

TAX ID #: WOB 00003

## **PLAT OF SURVEY**


-OF-

LOT 2 OF OBSERVATORY SUBDIVISION, LOCATED IN THE VILLAGE OF WILLIAMS BAY, WALWORTH COUNTY WISCONSIN.

PATHFINDER SURVEYING INC. W2888 KRUGER ROAD, UNIT "D" LAKE GENEVA, WI, 53147 262-248-3697

## GENEVA STREET

(50' WIDE)

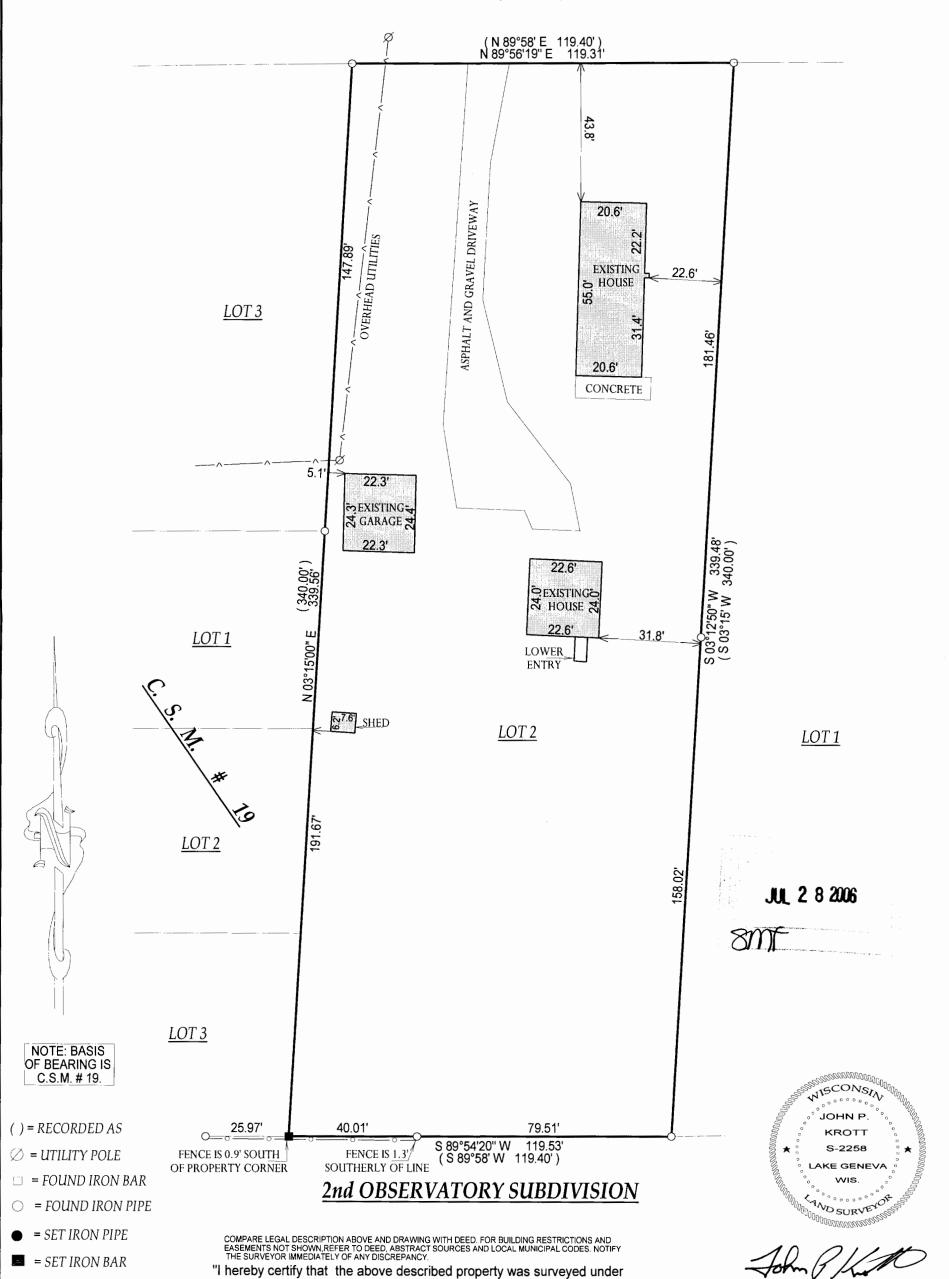

my supervision and that the above map, to the best of my knowledge and

belief, is a true representation thereof and shows the size and location of

all visible structures, apparent easements and encroachments if any."

This survey is made for the present owners of the property, and those who purchase, mortgage, or guarantee the title thereto, within one year

from the date hereof.

JOHN KROTT S - 2258 Wisconsin Registered Land Surveyor ( original if signed in red )

DATED THE 31st DAY OF MAY, 2006.

011-3068