

FARRIS, HANSEN & ASSOCIATES, INC.

ENGINEERING — ARCHITECTURE — SURVEYING
7 RIDGWAY COURT — P.O. BOX 437 — ELKHORN, WISCONSIN 53121
PHONE: (262) 723-2098 FAX: (262) 723-5886

PLAT OF SURVEY

4. The land referred to in this Commitment is described as follows:

An undivided 1/2 interest in and to the following:


The North 2.5 feet of Lot 235, Lot 236 and S 1/2 of Lot 237, Cedar Point Park
3rd Addition, Village of Williams Bay, Walworth County, Wisconsin.

Tax Key No. WCP3 00031.


— WORK ORDERED BY —
CLAIR LAW OFFICE
PO BOX 445
DELAVAN, WI. 53115-0445
FOR OLIN TRUST

ASSIGNED EAST LINE CIRCLE PARKWAY
N 00°00'00" E

CIRCLE PARKWAY
40' ROW

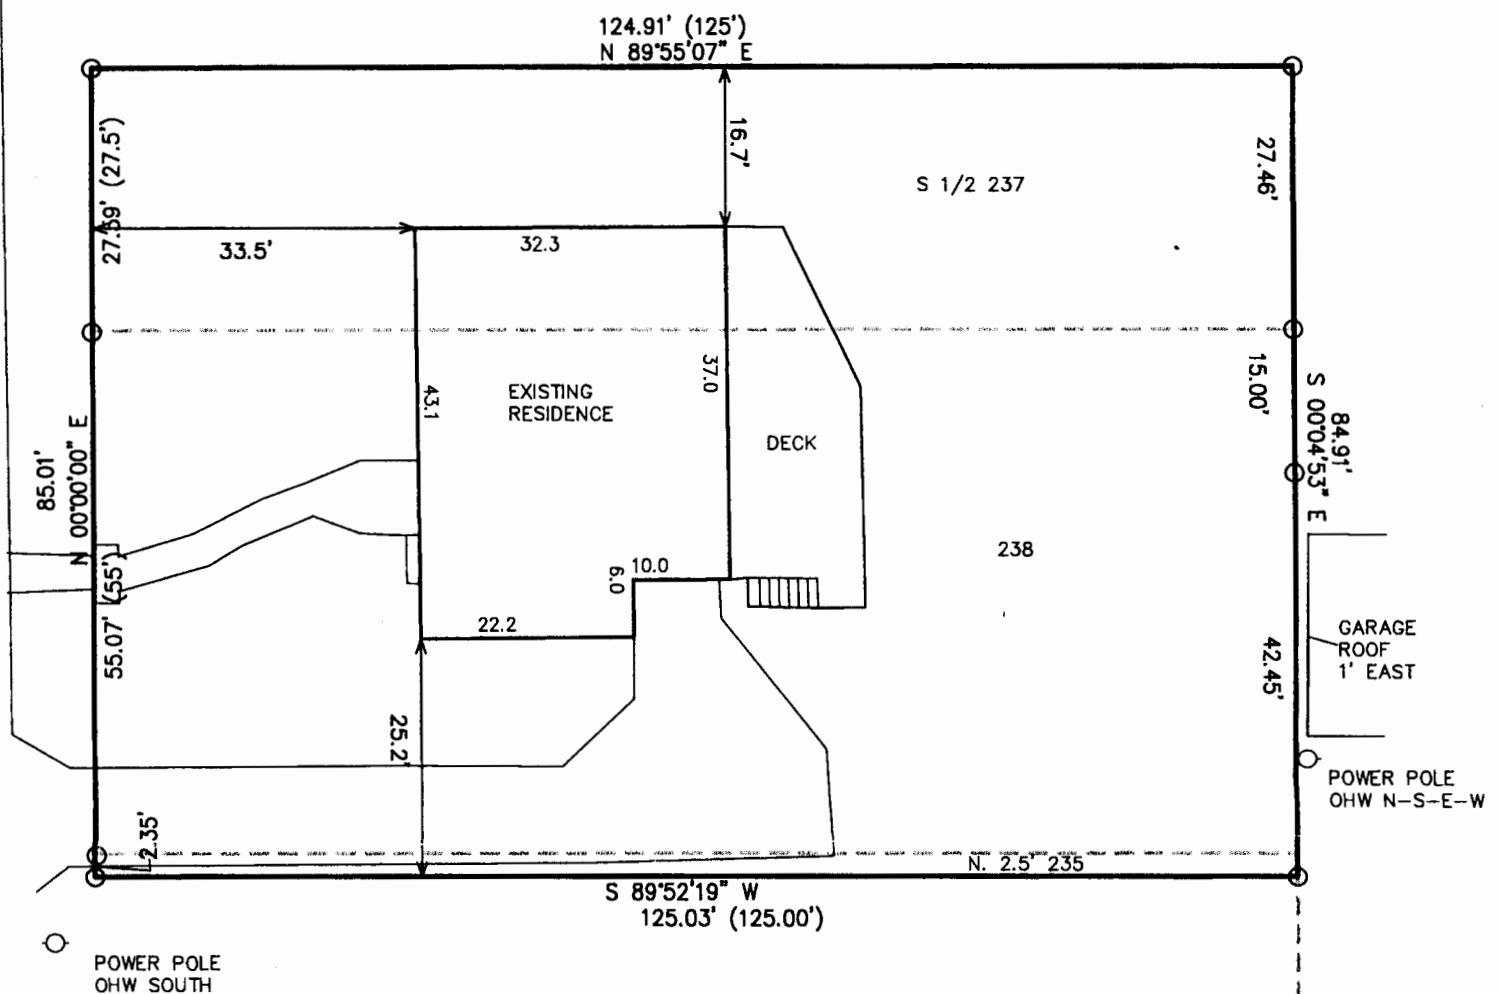


AREA SURVEYED = 10,615 S.F. (0.24 AC.)

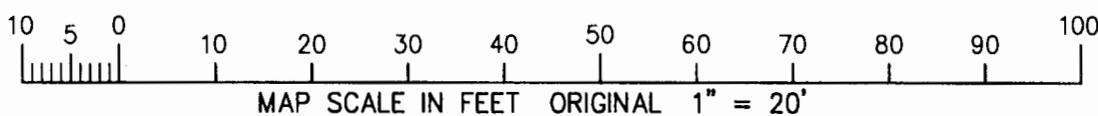

LEGEND

- = FOUND IRON PIPE STAKE
- = SET IRON REBAR STAKE
- (XXX) = RECORDED AS

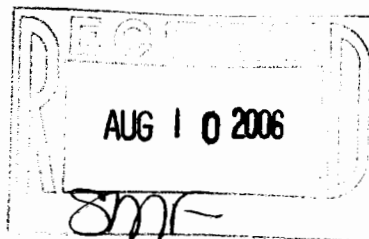

EASEMENTS REFERENCED IN TITLE ARE GENERAL FOR UTILITIES OVER THE ROADS, PARKS, AND DRIVEWAYS WITHIN CEDAR POINT PARK WITH NO SPECIFIC WIDTH OR LOCATION.

NOTE: COPIES OF THIS MAP TO WHICH THE FOLLOWING CERTIFICATE WILL APPLY SHOW SURVEYOR'S ORIGINAL SEAL AND SIGNATURE IN RED INK. COPIES BY ANY OTHER MEANS MAY HAVE ALTERATIONS WHICH DO NOT REPRESENT THE SURVEYOR'S WORK PRODUCT.

I HEREBY CERTIFY THAT THE ABOVE DESCRIBED PROPERTY HAS BEEN SURVEYED UNDER MY DIRECTION AND THAT THE ABOVE MAP IS A TRUE REPRESENTATION THEREOF AND SHOWS THE SIZE AND LOCATION OF THE PROPERTY, ITS EXTERIOR BOUNDARIES, THE LOCATION OF ALL VISIBLE STRUCTURES, AND DIMENSIONS OF ALL PRINCIPLE BUILDINGS THEREON, BOUNDARY FENCES, APPARENT EASEMENTS, ROADWAYS, AND VISIBLE ENCROACHMENTS, IF ANY. THIS SURVEY IS MADE FOR THE USE OF THE PRESENT OWNERS OF THE PROPERTY, AND ALSO THOSE WHO PURCHASE, MORTGAGE, OR GUARANTEE THE TITLE THERETO WITHIN ONE YEAR FROM THE DATE HEREOF.

DATED: JULY 19, 2006

Peter S. Gordon
PETER S. GORDON R.L.S. 2101

PROJECT: 7108
DATE: 07-19-2006
SHEET 1 OF 1

WCP3-31

011-2075