
RIC'd 10/18/06 8/10/

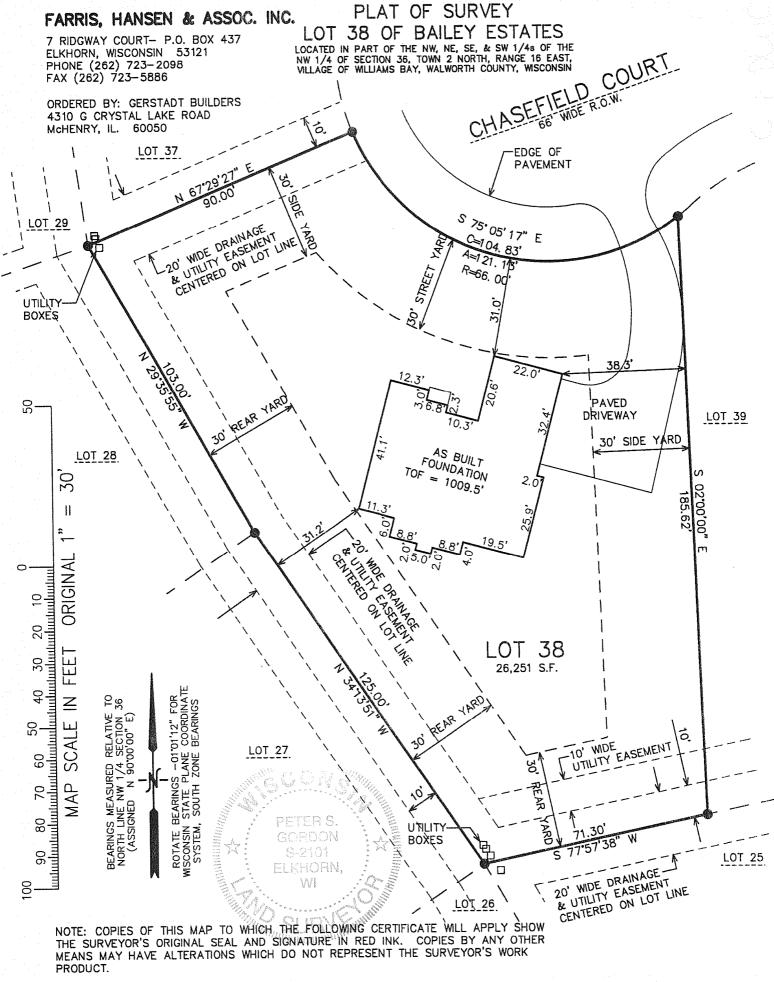

I HEREBY CERTIFY THAT THE ABOVE DESCRIBED PROPERTY HAS BEEN SURVEYED UNDER MY DIRECTION AND THAT THE ABOVE MAP IS A TRUE REPRESENTATION THEREOF AND SHOWS THE SIZE AND LOCATION OF THE PROPERTY, ITS EXTERIOR BOUNDARIES, THE LOCATION OF ALL VISIBLE STRUCTURES, AND DIMENSIONS OF ALL PRINCIPLE (XXX) BUILDINGS THEREON, BOUNDARY FENCES, APPARENT EASEMENTS, ROADWAYS, AND VISIBLE ENCROACHMENTS, IF ANY. THIS SURVEY IS MADE FOR THE USE OF THE PRESENT OWNERS OF THE PROPERTY, AND ALSO THOSE WHO PURCHASE, MORTGAGE, OR GUARANTEE THE TITLE THERETO WITHIN ONE YEAR FROM THE DATE HEREOF.

DATED: DECEMBER 21, 2005

REVISED 06/05/2006 TO SHOW SIZE AND LOCATION OF PROPOSED RESIDENCE REVISED 09-27-2006 UPDATE TO TITLE SPECS.

**LEGEND** 

RECORDED AS

REVISED 07-05-2006 TO SHOW SIZE & LOCATION OF AS BUILT FOUNDATION PROJECT NO. 3249.38 DATED: 12-21-2005 SHEET 1 OF 1 SHEETS

FOUND IRON REBAR STAKE

WBAIL -38

PETER S. GORDON

1-2000