
PREPARED FOR: DAVID GUNDERSEN 62 CLOVER ST. WILLIAMS BAY, WI 53191

PLAT OF SURVEY

PATHFINDER SURVEYING INC. W2888 KRUEGER RD. UNIT D LAKE GENEVA WI. 53147

- OF -

LOT 16, BLOCK 10 OF WILLIAM'S SECOND ADDITION TO THE VILLAGE OF WILLIAMS BAY, WALWORTH COUNTY, WISCONSIN.

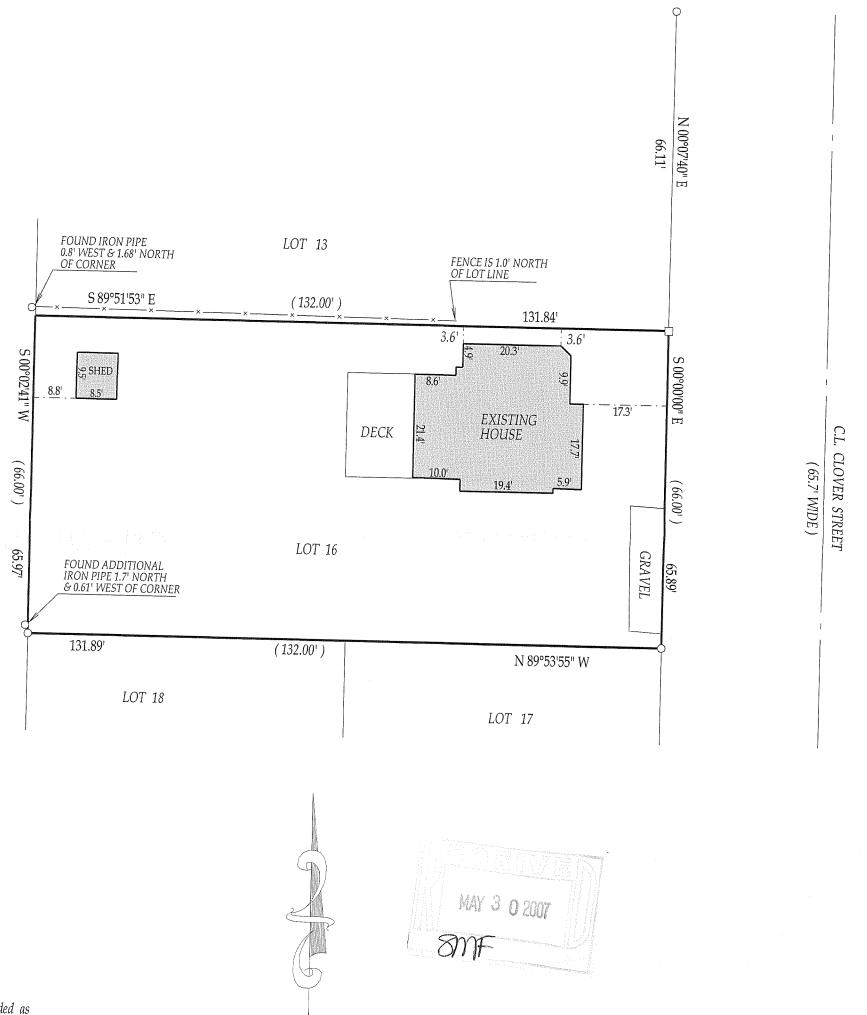

()= recorded as

🗆 = found iron bar

○ = found iron pipe

= set iron pipe

= set iron bar

SCALE 1" = 20'

JOB # 07-174

TAX ID # WOP00147

COMPARE LEGAL DESCRIPTION ABOVE AND DRAWING WITH DEED. FOR BUILDING RESTRICTIONS AND EASEMENTS NOT SHOWN, REFER TO DEED, ABSTRACT SOURCES AND LOCAL MUNICIPAL CODES. NOTIFY THE SURVEYOR IMMEDIATELY OF ANY DISCREPANCY.

"I hereby certify that I have surveyed the above described property and that the above map is a true representation thereof and shows the size and location of all visible structures, apparent easements and encroachments if any."

This survey is made for the present owners of the property, and those who purchase, mortgage, or guarantee the title thereto, within one year from the date hereof.

DATED THIS 10th, DAY OF MAY, 2007



John Photo C 2250

JOHN KROTT S - 2258 Wisconsin Registered Land Surveyor (original if signed in red)