



PREPARED FOR
DAVID SIDNEY
THE BUCKLEY COMPANIES
363 FINANCIAL COURT, SUITE 200
ROCKFORD, ILL. 61107

PLAT OF SURVEY

- OF -

LOT 61 AND 62 OF LACKEY BROTHERS SUBDIVISION LOCATED IN THE
VILLAGE OF WILLIAMS BAY, WALWORTH COUNTY, WISCONSIN.

PATHFINDER SURVEYING INC.
W2888 KRUEGER RD. UNIT "D"
LAKE GENEVA WI. 53147
(262) 248-3697

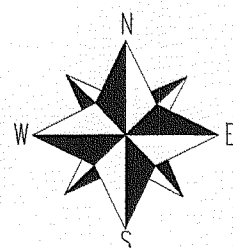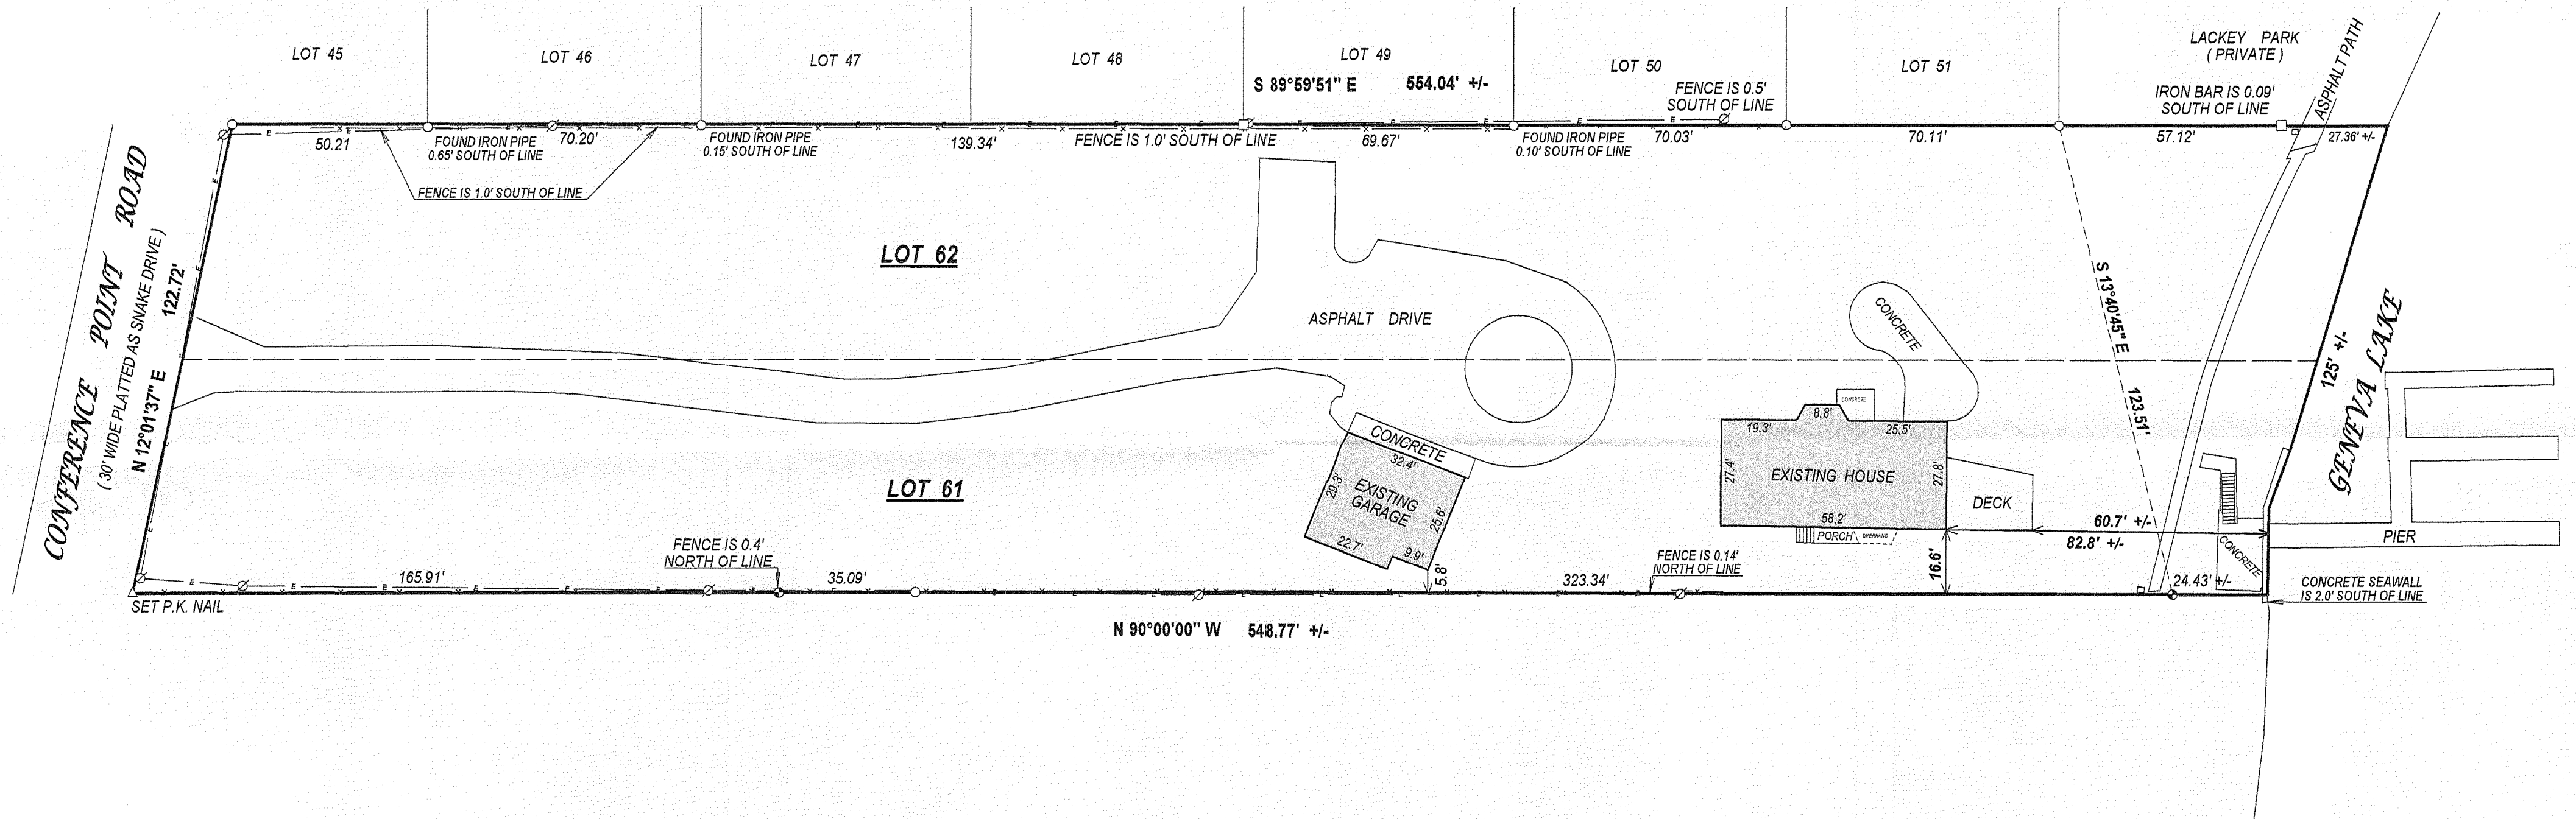


- ⊘ = power pole
- = overhead wires
- ⊙ = concrete monument
- () = recorded as
- = found iron bar
- = found iron pipe
- = set iron bar

SCALE 1" = 30'


JOB # 07-340

TAX ID # WLB00060 & 61

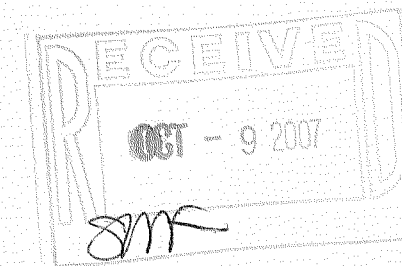

COMPARE LEGAL DESCRIPTION ABOVE AND DRAWING WITH DEED. FOR BUILDING RESTRICTIONS AND EASEMENTS NOT SHOWN REFER TO DEED, ABSTRACT SOURCES AND LOCAL MUNICIPAL CODES. NOTIFY THE SURVEYOR IMMEDIATELY OF ANY DISCREPANCY.

"I hereby certify that I have surveyed the above described property and that the above map, to the best of my knowledge and belief, is a true representation thereof and shows the size and location of all visible structures, apparent easements and encroachments if any."
This survey is made for the present owners of the property, and those who purchase, mortgage, or guarantee the title thereto, within one year from the date hereof.

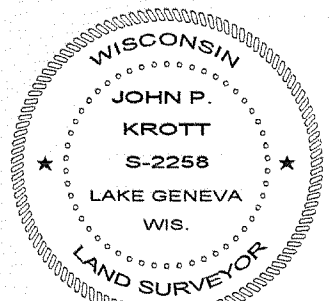

John P. Krott
JOHN KROTT S - 2258
Wisconsin Registered Land Surveyor
(original if signed in red)

DATED THIS THE 17th DAY OF SEPTEMBER 2007.

011-2164