


GRID NORTH  
WISCONSIN STATE PLANE COORDINATE SYSTEM - SOUTH ZONE  
ASSIGNED E. LINE OF THE NORTHEAST 1/4  
SECTION 6-1-17  
N 02°08'44" W

# PLAT OF SURVEY



## LOT 1 OF CERTIFIED SURVEY MAP NO. 4083

BEING LOTS 18 AND 19, BLOCK 1 OF HARBOR VIEW SUBDIVISION LOCATED IN PART  
OF THE SOUTHEAST 1/4 OF THE NORTHEAST 1/4 OF SECTION 6, TOWN 1 NORTH,  
RANGE 17 EAST, VILLAGE OF WILLIAMS BAY, WALWORTH COUNTY, WISCONSIN

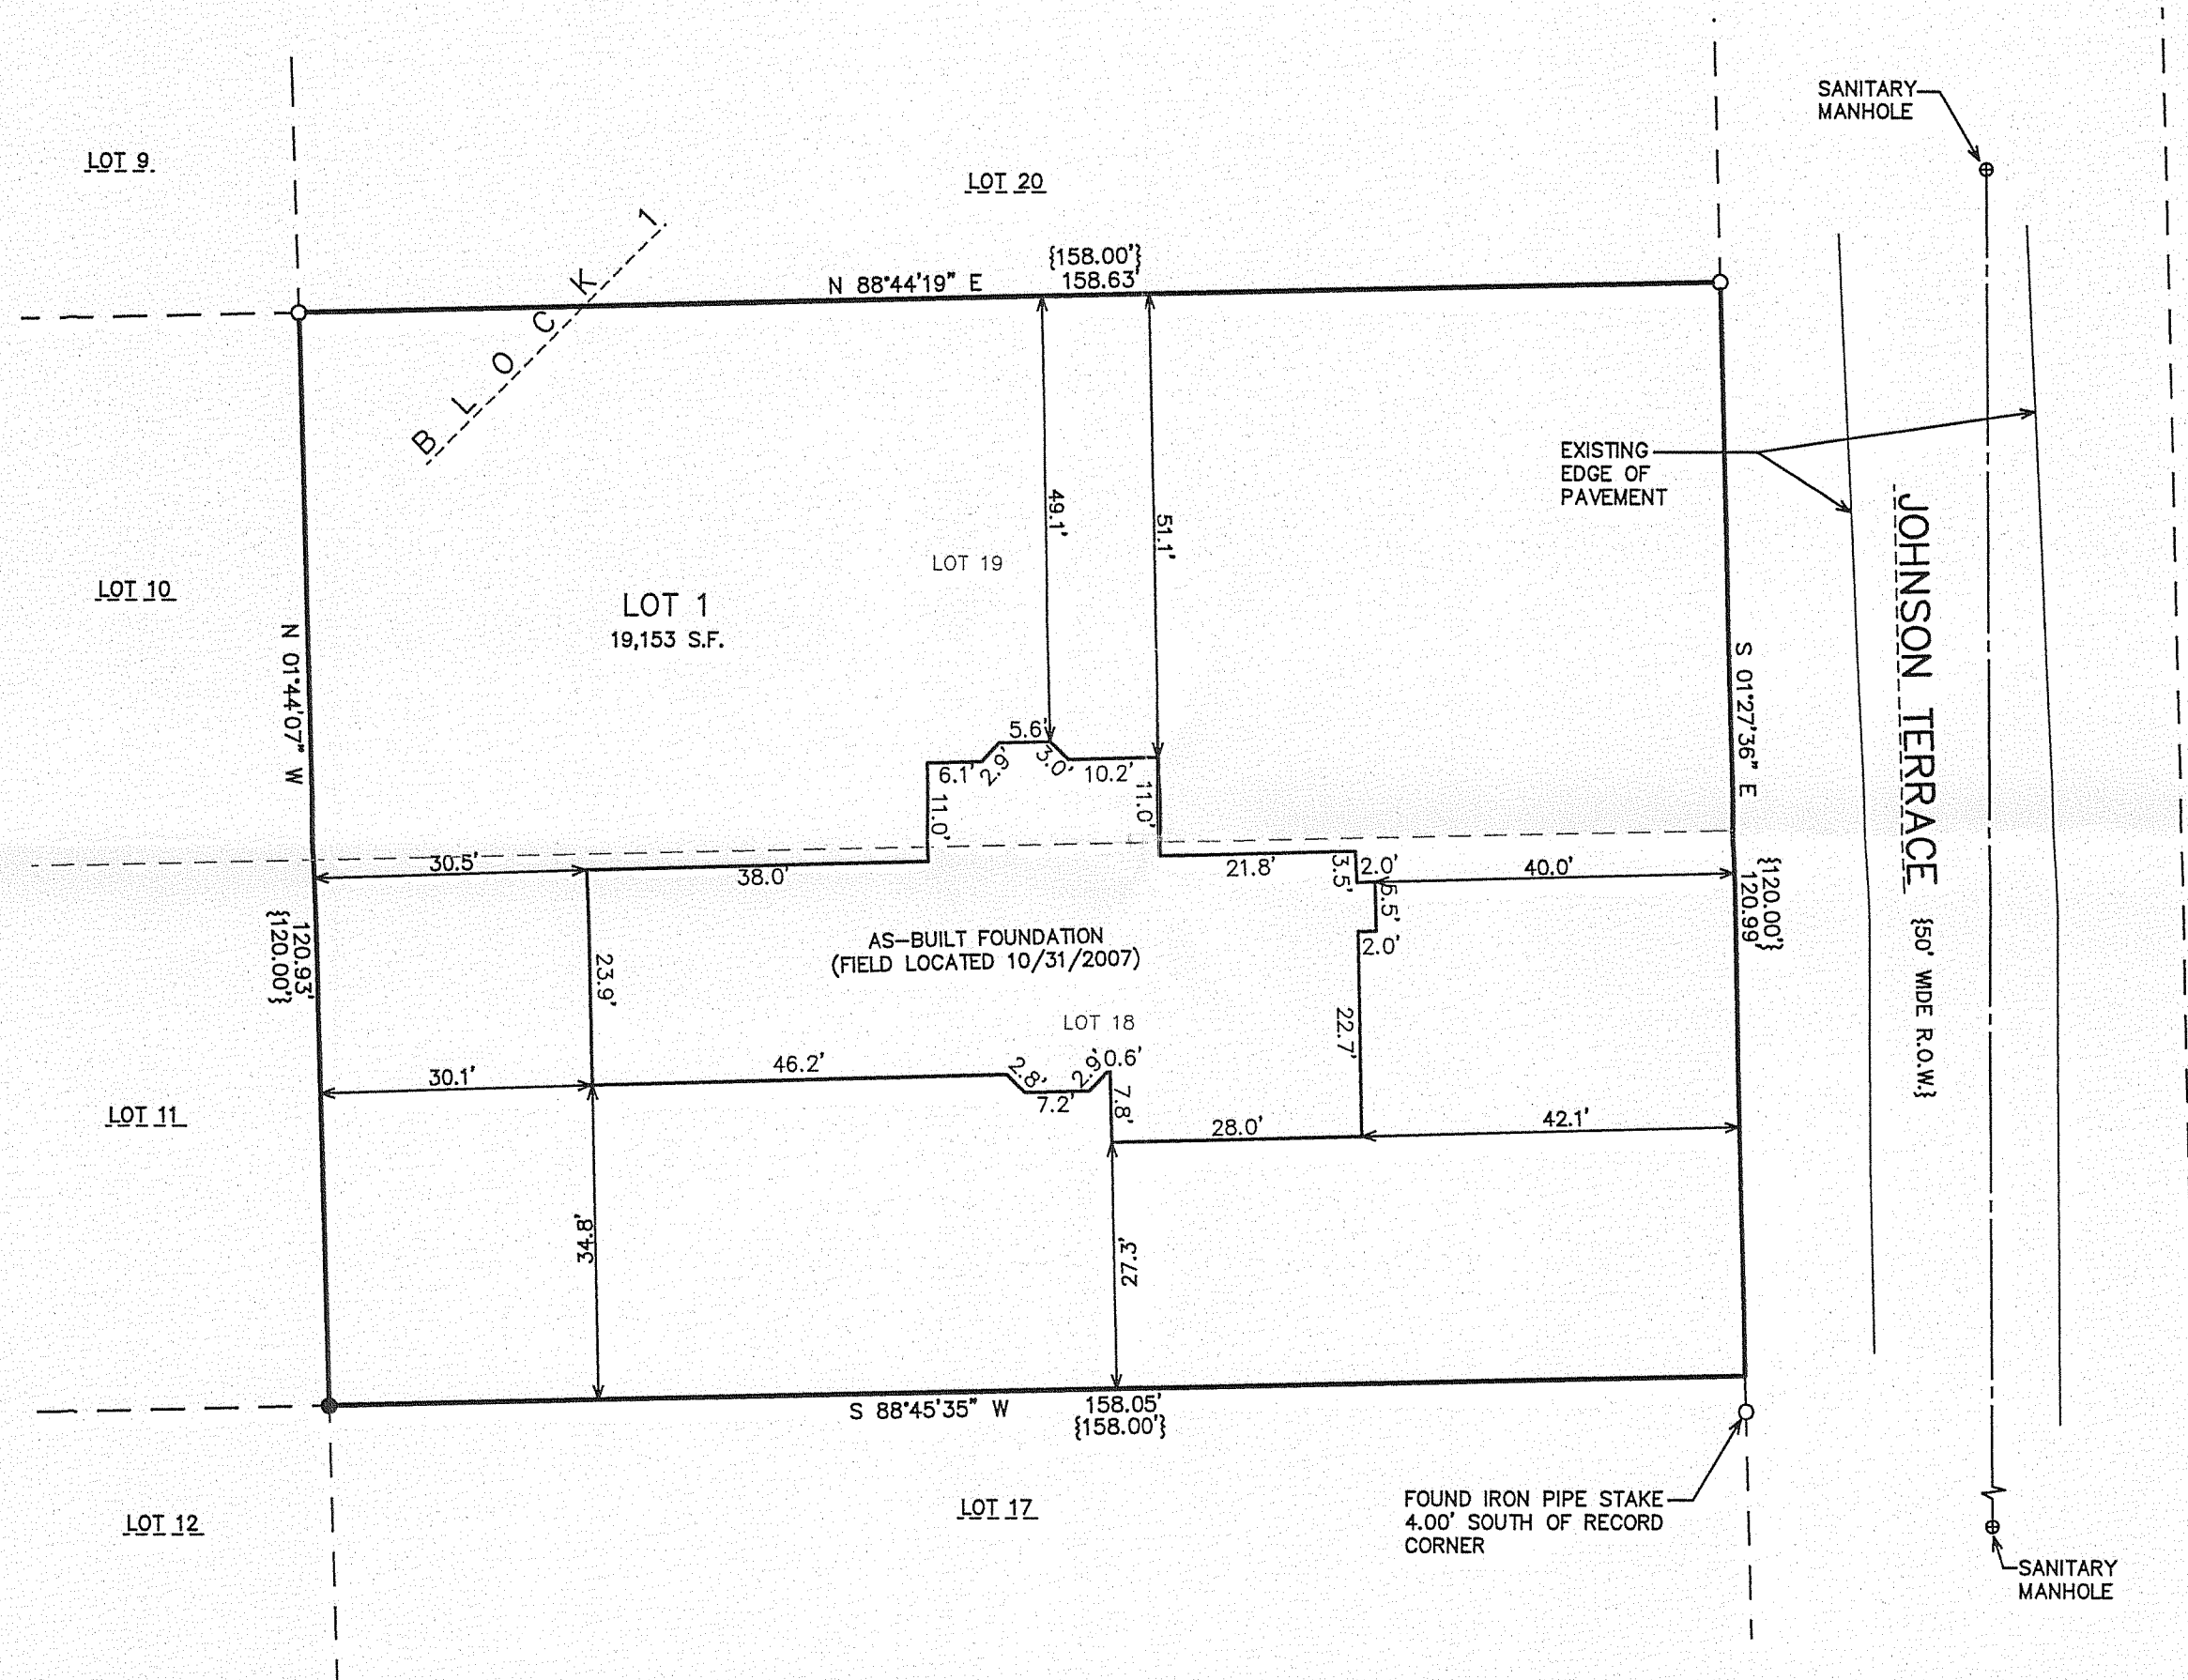

### LEGEND

- = FOUND IRON REBAR STAKE
- = FOUND IRON PIPE STAKE
- {xxx} = RECORDED AS

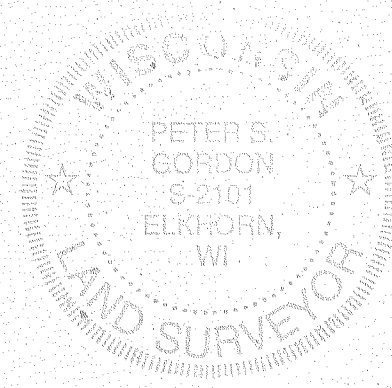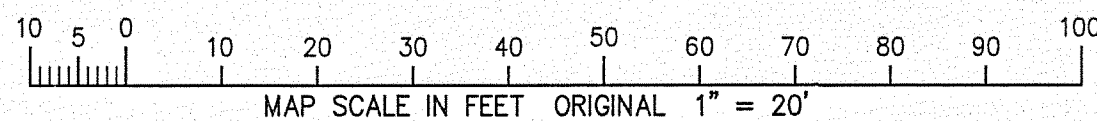


NOTE: COPIES OF THIS MAP TO WHICH THE FOLLOWING CERTIFICATE  
WILL APPLY THE SURVEYOR'S ORIGINAL SEAL AND SIGNATURE  
IN RED INK. COPIES BY ANY OTHER MEANS MAY HAVE ALTERATIONS  
WHICH DO NOT REPRESENT THE SURVEYOR'S WORK PRODUCT.

I HEREBY CERTIFY THAT THE ABOVE DESCRIBED PROPERTY HAS BEEN  
SURVEYED UNDER MY DIRECTION AND THAT THE ABOVE MAP IS A TRUE  
REPRESENTATION THEREOF AND SHOWS THE SIZE AND LOCATION OF  
THE PROPERTY AND ITS EXTERIOR BOUNDARIES. THIS SURVEY IS  
MADE FOR THE USE OF THE PRESENT OWNERS OF THE PROPERTY, AND  
ALSO THOSE WHO PURCHASE, MORTGAGE, OR GUARANTEE THE TITLE  
THERE TO WITHIN ONE YEAR FROM THE DATE HEREOF.

DATED: AUGUST 24, 2007

*Peter S. Gordon*  
PETER S. GORDON R.L.S. 2101

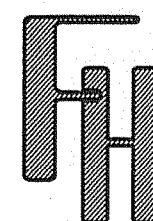

WORK ORDERED BY -  
RUTH WRIGHT  
P.O. BOX 9839  
CORAL SPRINGS, FL 33075

FARRIS, HANSEN & ASSOCIATES, INC.  
ENGINEERING - ARCHITECTURE - SURVEYING  
7 RIDGWAY COURT P.O. BOX 437  
ELKHORN, WISCONSIN 53121  
OFFICE: (262) 723-2098 FAX: (262) 723-5886

### REVISIONS

11/1/2007-KB  
TO SHOW SIZE  
AND LOCATION  
OF AS-BUILT  
FOUNDATION

PROJECT NO.  
6298  
DATE:  
8/24/2007  
SHEET NO.  
1 OF 1

X:\Projects\6298\Draw\ASBLT\_20071101

11/1/2007

WA 4083-1

011-2187