## PLAT OF SURVEY

LOT 213 OF CEDAR POINT PARK 3rd ADDITION
LOCATED IN PART OF THE VILLAGE OF WILLIAMS BAY, WALWORTH COUNTY, WISCONSIN

TAX PARCEL WCP3 00011



ORK ORDERED BY — HEIM FAMILY TRUSTS EFE REAL ESTATE, INC. LAKE GENEVA WISCONSIN


ARCHITECTURE — SURVEYING
COURT P.O. BOX 437
WSCONSIN 53121

FARRIS, H ENGINEERIN 7 RII

REVISIONS

PROJECT NO.
7482
DATE:

11/14/2007 SHEET NO. 1 OF 1

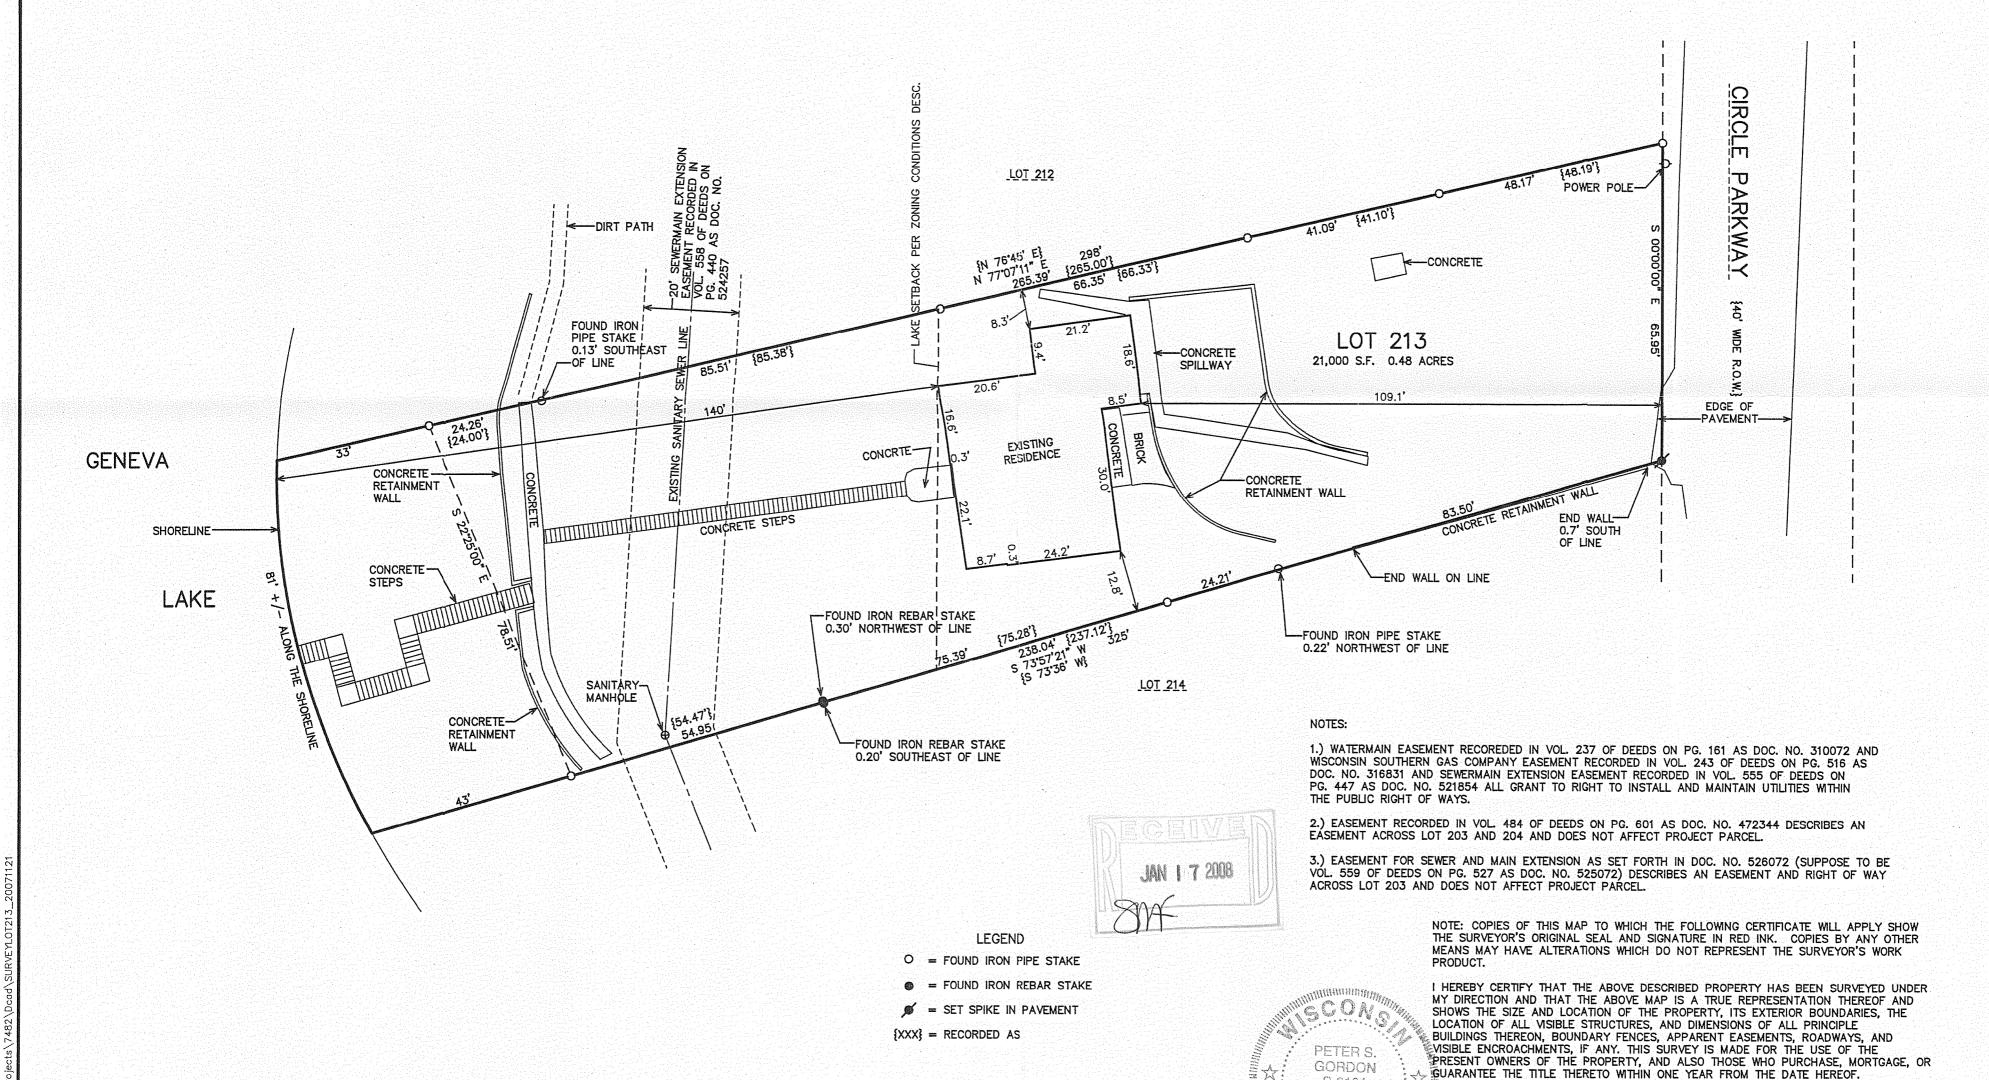

S-2101

ELKI-KORN,

W

DATED: JANUARY 4, 2008

PÉTER S. GORDON

70

MAP SCALE IN FEET ORIGINAL 1" = 20"

80