

LAND-MARK SURVEYING


Mark L. Miritz

Wisconsin Registered Land Surveyor S-2582

N9330 Knuteson Drive
Whitewater, WI 53190
Phone: (262) 495-3284
FAX : (262) 495-8421
LAND-MARKSURVEYING.COM


PLAT OF SURVEY

LOT 3 OF CERTIFIED SURVEY MAP NO. 3927 AS RECORDED IN VOL. 24 OF CERTIFIED SURVEY MAPS, ON PAGE 82, LOCATED IN THE SOUTHEAST 1/4 OF THE SOUTHEAST 1/4 OF SECTION 1. TOWN 1 NORTH, RANGE 16 EAST, VILLAGE OF WILLIAMS BAY, WALWORTH COUNTY, WISCONSIN.

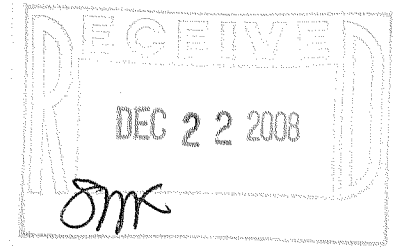

**OWNERS: CHARLES E. MILLER
JOAN C. MILLER
6901 LEXINGTON TRAIL
CYRSTAL LAKE, IL. 60012**

GLENWOOD EST. SUBD.

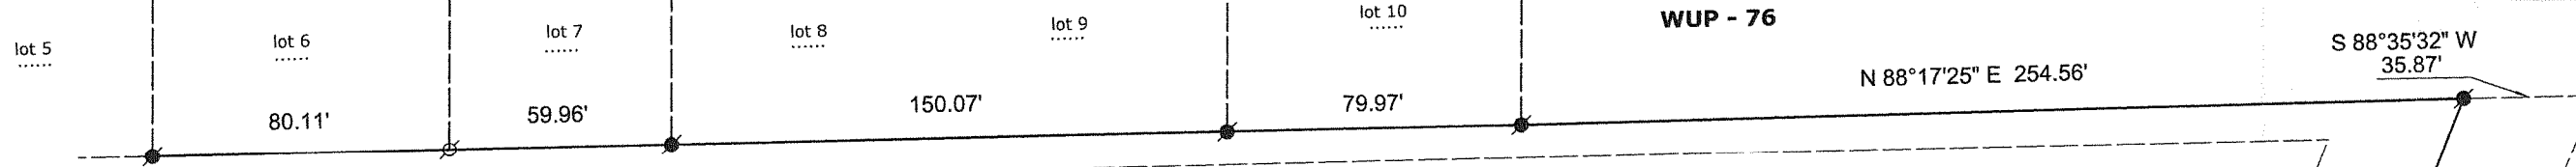


WUP - 76

N 88°41'08" E 700.02'

PART OF LOT 2

S 88°35'32" W 35.87'

N 88°41'08" E 586.94'

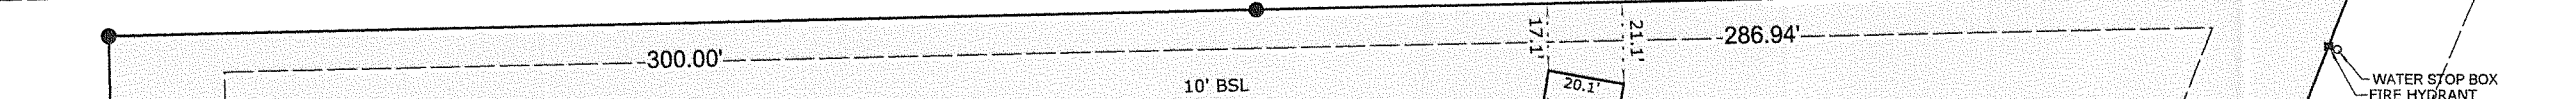


EXISTING RESIDENCE

**CSM NO. 3927
LOT 3**

113,366 S.F. (2.60 AC.)


PART OF LOT 2

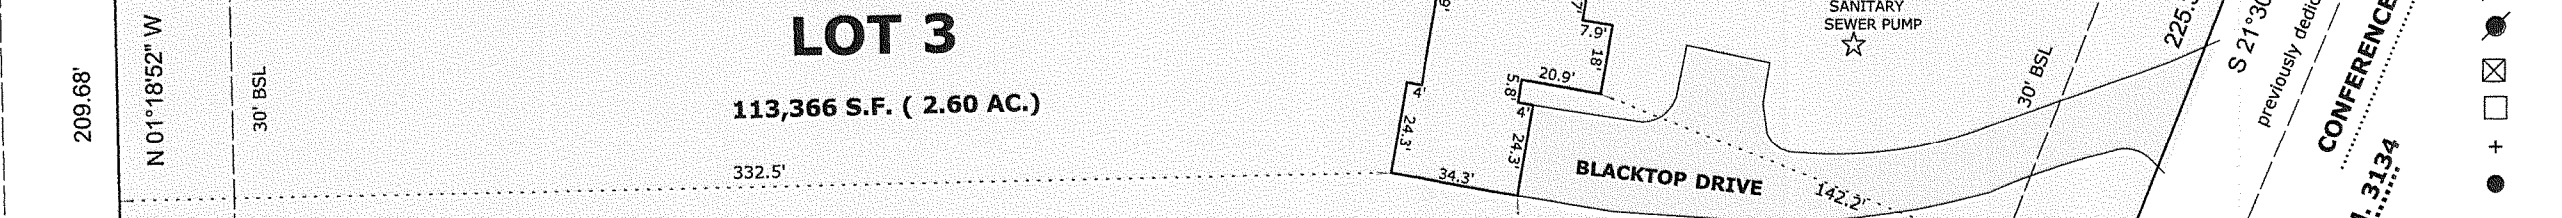

SANITARY SEWER PUMP

WATER STOP BOX
FIRE HYDRANT

S 21°30'27" W 292.36'
previously dedicated to the public
CONFERENCE POINT ROAD
C.S.M. 3134

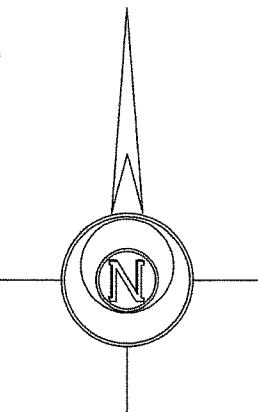


LEGEND

- FOUND IRON PIPE
- FOUND IRON ROD
- FOUND COUNTY MONUMENT
- FOUND CONCRETE MONUMENT
- CHISEL CUT IN CONCRETE
- SET IRON ROD, 24" LONG, WEIGHING 1.5 LBS./LINEAL FT., 3/4" DIA.
- (x x) RECORDED AS DIMENSION
- x - x - EXISTING FENCE

SCALE: 1" = 50 FEET

"I hereby certify that the above described property has been surveyed by me or under my direction and that the above map is a true representation thereof and shows the size and location of the property, its exterior boundaries, the location of all visible structures and dimensions of all principal buildings thereon, boundary fences, apparent easements, roadways and visible encroachments, if any."
"This survey is made for the use of the present owners of the property, and also those who purchase, mortgage, or guarantee the title thereto within one year from date hereof."

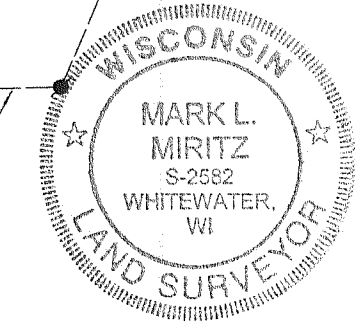

Mark L. Miritz
MARK L. MIRITZ
WISCONSIN REGISTERED
LAND SURVEYOR S-2582

REVISED 11/06/2008 TO SHOW RESIDENCE "AS BUILT" DATE: **NOV.5, 2006** JOB NO. **06.304**

WA3927-3

011-2242