FARRIS, HANSEN & ASSOC. INC.


7 RIDGWAY COURT— P.O. BOX 437 ELKHORN, WSCONSIN 53121 PHONE (262) 723—2098 FAX (262) 723—5886

ORDERED BY: ALL SEASONS REMODELING W8205 NATURE DRIVE WHITEWATER, W. 53190

PLAT OF SURVEY

LOT 12 WILLABAY WOODS

LOCATED IN THE NE 1/4 OF THE NE 1/4
SEC. 6, T1N, R17E,
CILLAGE OF WILLIAMS BAY
WALWORTH COUNTY, WI.

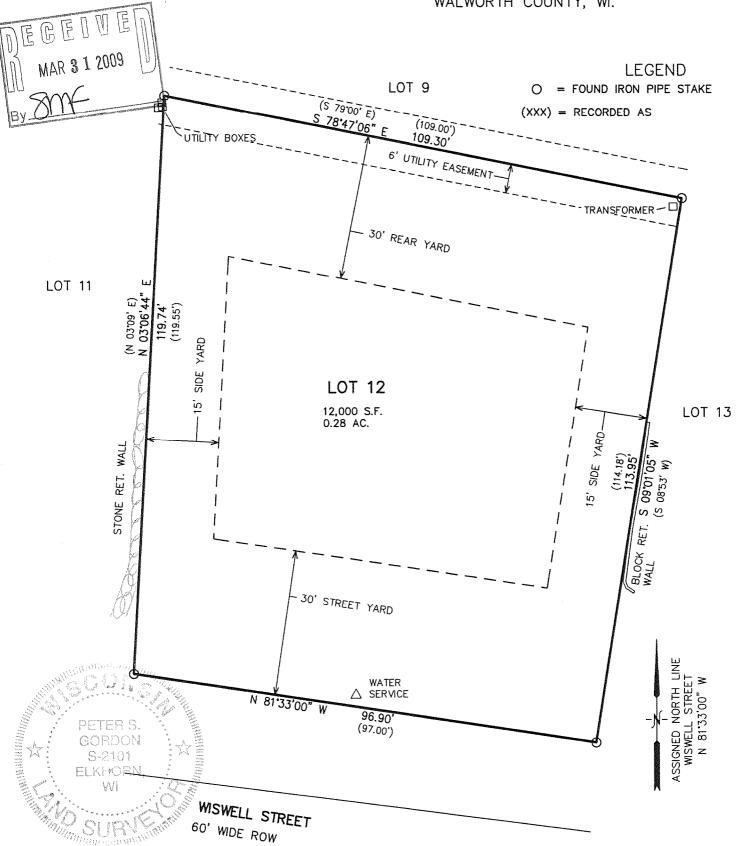

NOTE: COPIES OF THIS MAP TO WHICH THE FOLLOWING CERTIFICATE WILL APPLY SHOW SURVEYOR'S ORIGINAL SEAL AND SIGNATURE IN RED INK. COPIES BY ANY OTHER MEANS MAY HAVE ALTERATIONS WHICH DO NOT REPRESENT THE SURVEYOR'S WORK PRODUCT.

I HEREBY CERTIFY THAT THE ABOVE DESCRIBED PROPERTY HAS BEEN SURVEYED UNDER MY DIRECTION AND THAT THE ABOVE MAP IS A TRUE REPRESENTATION THEREOF AND SHOWS THE SIZE AND LOCATION OF THE PROPERTY AND ITS EXTERIOR BOUNDARIES. THIS SURVEY IS MADE FOR THE USE OF THE PRESENT OWNERS OF THE PROPERTY, AND ALSO THOSE WHO PURCHASE, MORTGAGE, OR GUARANTEE THE TITLE THERETO WITHIN ONE YEAR FROM THE DATE HEREOF.

DATED: MARCH 4, 2009

PETER S. GORDON R.L.S. 2101

don

PROJECT NO. 7840 DATED: 03-04-2009 SHEET 1 OF 1 SHEETS

MAR 04 200

10 5 0 10 20 30 40 50 60 70 80 90 100 MAP SCALE IN FEET ORIGINAL 1" = 20'

011 2250