

LAND-MARK SURVEYING

Mark L. Miritz
Wisconsin Registered Land Surveyor S-2582

N9330 Knuteson Drive
Whitewater, WI 53190
Phone:(262)495-3284
FAX : (262) 495-8421
LAND-MARKSURVEYING.COM


PLAT OF SURVEY

LOT 63 OF BAY VIEW SUBDIVISION,
LOCATED IN THE SOUTHEAST 1/4 OF
SECTION 1, TOWN 1 NORTH, RANGE
16 EAST, VILLAGE OF WILLIAMS BAY,
WALWORTH COUNTY, WISCONSIN.

ORDERED BY: SHARI RAULAND MOHR

THE RAULAND AGENCY
118 KENOSHA STREET
WALWORTH, WI 53184

SITE ADDRESS: 89 HIGHLAND STREET

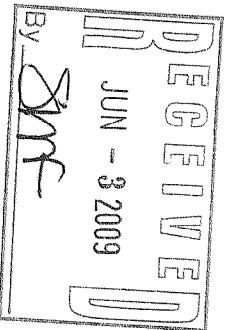

LOT 62

LOT 63
9,586 SQ. FT.

LOT 66

HIGHLAND STREET

50' WIDE

S 88°30'18" W 50.03'

N 00°17'21" E 55.66'

N 88°45'30" E 159.95' (160')

S 87°37'21" W 159.80' (160')

N 87°43'35" E 159.93' (160')

S 00°08'04" W 59.87' (60')

N 00°01'42" E 58.82' (58.22')

UNIMPROVED ALLEY 16' WIDE

LEGEND



FOUND IRON PIPE
(x x)
RECORDED AS DIMENSION
EXISTING FENCE

SCALE: 1" = 20 FEET

"I hereby certify that the above described property has been surveyed by me or under my direction and that the above map is a true representation thereof and shows the size and location of the property, its exterior boundaries, the location of all visible structures and dimensions of all principal buildings thereon, boundary fences, apparent easements, roadways and visible encroachments, if any."

Mark L. Miritz
MARK L. MIRITZ
WISCONSIN REGISTERED
LAND SURVEYOR S-2582

DATE: APRIL 30, 2009 JOB NO. 09.405

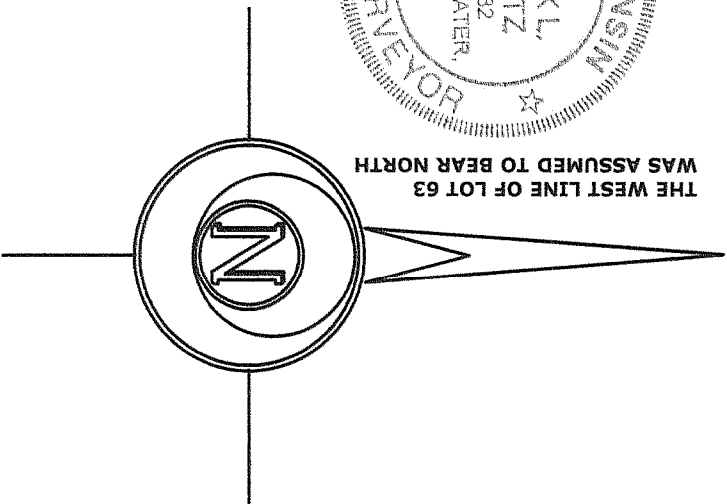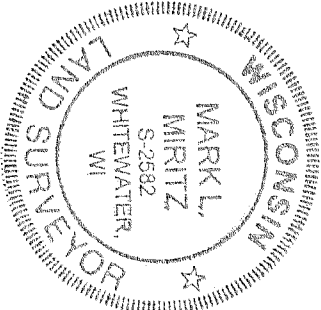

WBV - 35

011-22162