
PREPARED FOR GAETANO LOLLINO 1838 N. 78th CT. ELMWOOD PARK IL. 60707

KROTT SURVEYING INC. N3705 WILLOW BEND LANE LAKE GENEVA WI. 53147 PHONE # (262)248-3697 FAX # (262)249-0639

WILMETTE

ROAD

(40' WIDE ROAD)

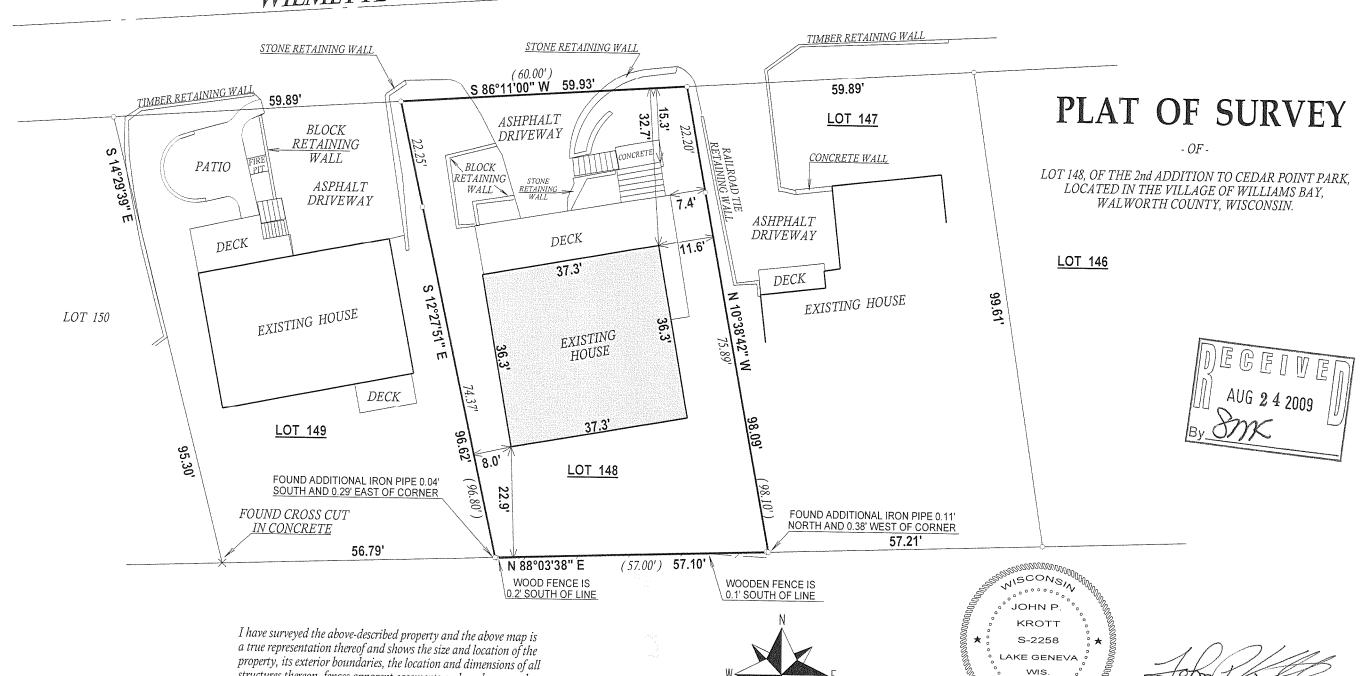

20

LEGEND

O FOUND IRON PIPE


(XX) RECORDED AS TAX ID #(WCP200044)

JOB # 02-194UD1

NOTE: BEARINGS ARE ASSUMED.

structures thereon, fences apparent easements and roadways and visible encroachments, if any,

This survey is made for the exclusive use of the present owners of the property, and also those who puchase, mortgage, or insure the title therto within one (1) year from date hereof; and as to them I warrant the accuracy of said survey map.

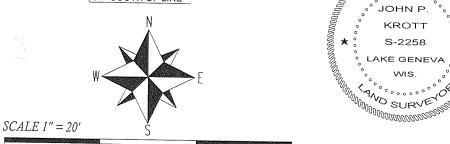

JOHN KROTT S - 2258 Wisconsin Registered Land Surveyor (original if signed in red)

DATE OF LAST REVISION AUGUST 19th, 2009. DATED THIS 30th DAY OF APRIL 2009.