FARRIS, HANSEN & ASSOC. INC.

7 RIDGWAY COURT- P.O. BOX 437 ELKHORN, WISCONSIN 53121 PHONE (262) 723-2098 FAX (262) 723-5886

ORDERED BY: JOHN STOCKS 641 DEER MEADOW TRAIL VALPARAISO, IN. 46385

LEGEND

FOUND IRON PIPE STAKE FOUND IRON REBAR STAKE SET IRON REBAR STAKE

SET WOOD LATH 5' OFFSET (XXX) = RECORDED AS AREA = 11,050 S.F. (0.25 AC.)AVE ROW

WEST LINE

(100,) 82 00.02

99.


JERNON AVE 2010

PLAT OF SURVEY

LOTS 9 & 10 LOCKWOODS SUBDIVISION

LOCATED IN THE NW 1/4 OF THE NE 1/4 SEC. 1 TOWN 1 NORTH, RANGE 16 EAST

VILLAGE OF WILLIAMS BAY, WALWORTH COUNTY, WI.

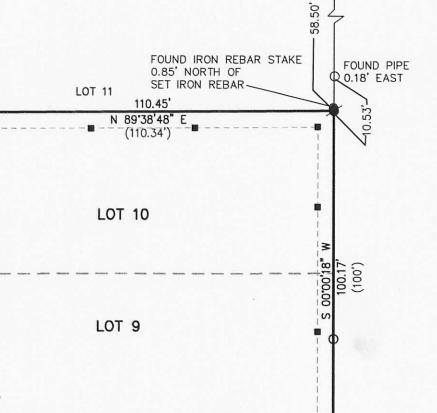

S 89'49'54" LOT 8 110.59 (110.58')99.83' 100 0 50 50 90 80 70 60 40 30 20 10 William Committee of the Committee of th

ORIGINAL 1" = 30"MAP SCALE IN FEET

NOTE: COPIES OF THIS MAP TO WHICH THE FOLLOWING CERTIFICATE WILL APPLY SHOW SURVEYOR'S ORIGINAL SEAL AND SIGNATURE IN RED INK. COPIES BY ANY OTHER MEANS MAY HAVE ALTERATIONS WHICH DO NOT REPRESENT THE SURVEYOR'S WORK PRODUCT.

I HEREBY CERTIFY THAT THE ABOVE DESCRIBED PROPERTY HAS BEEN SURVEYED UNDER MY DIRECTION AND THAT THE ABOVE MAP IS A TRUE REPRESENTATION THEREOF AND SHOWS THE SIZE AND LOCATION OF THE PROPERTY AND ITS EXTERIOR BOUNDARIES. THIS SURVEY IS MADE FOR THE USE OF THE PRESENT OWNERS OF THE PROPERTY, AND ALSO THOSE WHO PURCHASE, MORTGAGE, OR GUARANTEE THE TITLE THERETO WITHIN ONE YEAR FROM THE DATE HEREOF.

DATED: APRIL 30, 2010

PETER S. GORDON R.L.S. 2101

PROJECT NO. 8125 DATED: 04-30-2010 SHEET 1 OF 1 SHEET

PETER S. GORDON

S-2101 ELKHORN,

11-2315

APR 3 0 2010