


PREPARED FOR:  
PT CUSTOM CARPENTRY

# PLAT OF SURVEY


PATHFINDER SURVEYING INC.  
(formerly)  
J.K. SURVEYING INC.  
P.O. BOX 322  
LAKE GENEVA, WI, 53147  
262-248-8303

- OF -

THE SOUTH 1/4 OF LOT 207 AND ALL OF LOT 208, CEDAR POINT PARK THIRD ADDITION, VILLAGE OF WILLIAMS BAY, WALWORTH COUNTY, WISCONSIN

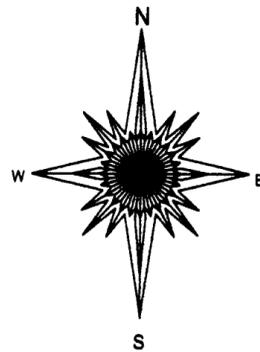

NOTE: BEARINGS ON THIS PLAT ARE REFERENCED THE RECORD PLAT OF THE THIRD ADDITION TO CEDAR POINT PARK, THE SOUTH LINE OF LOT 208 IS ASSUMED TO BEAR "S 88°41' W"

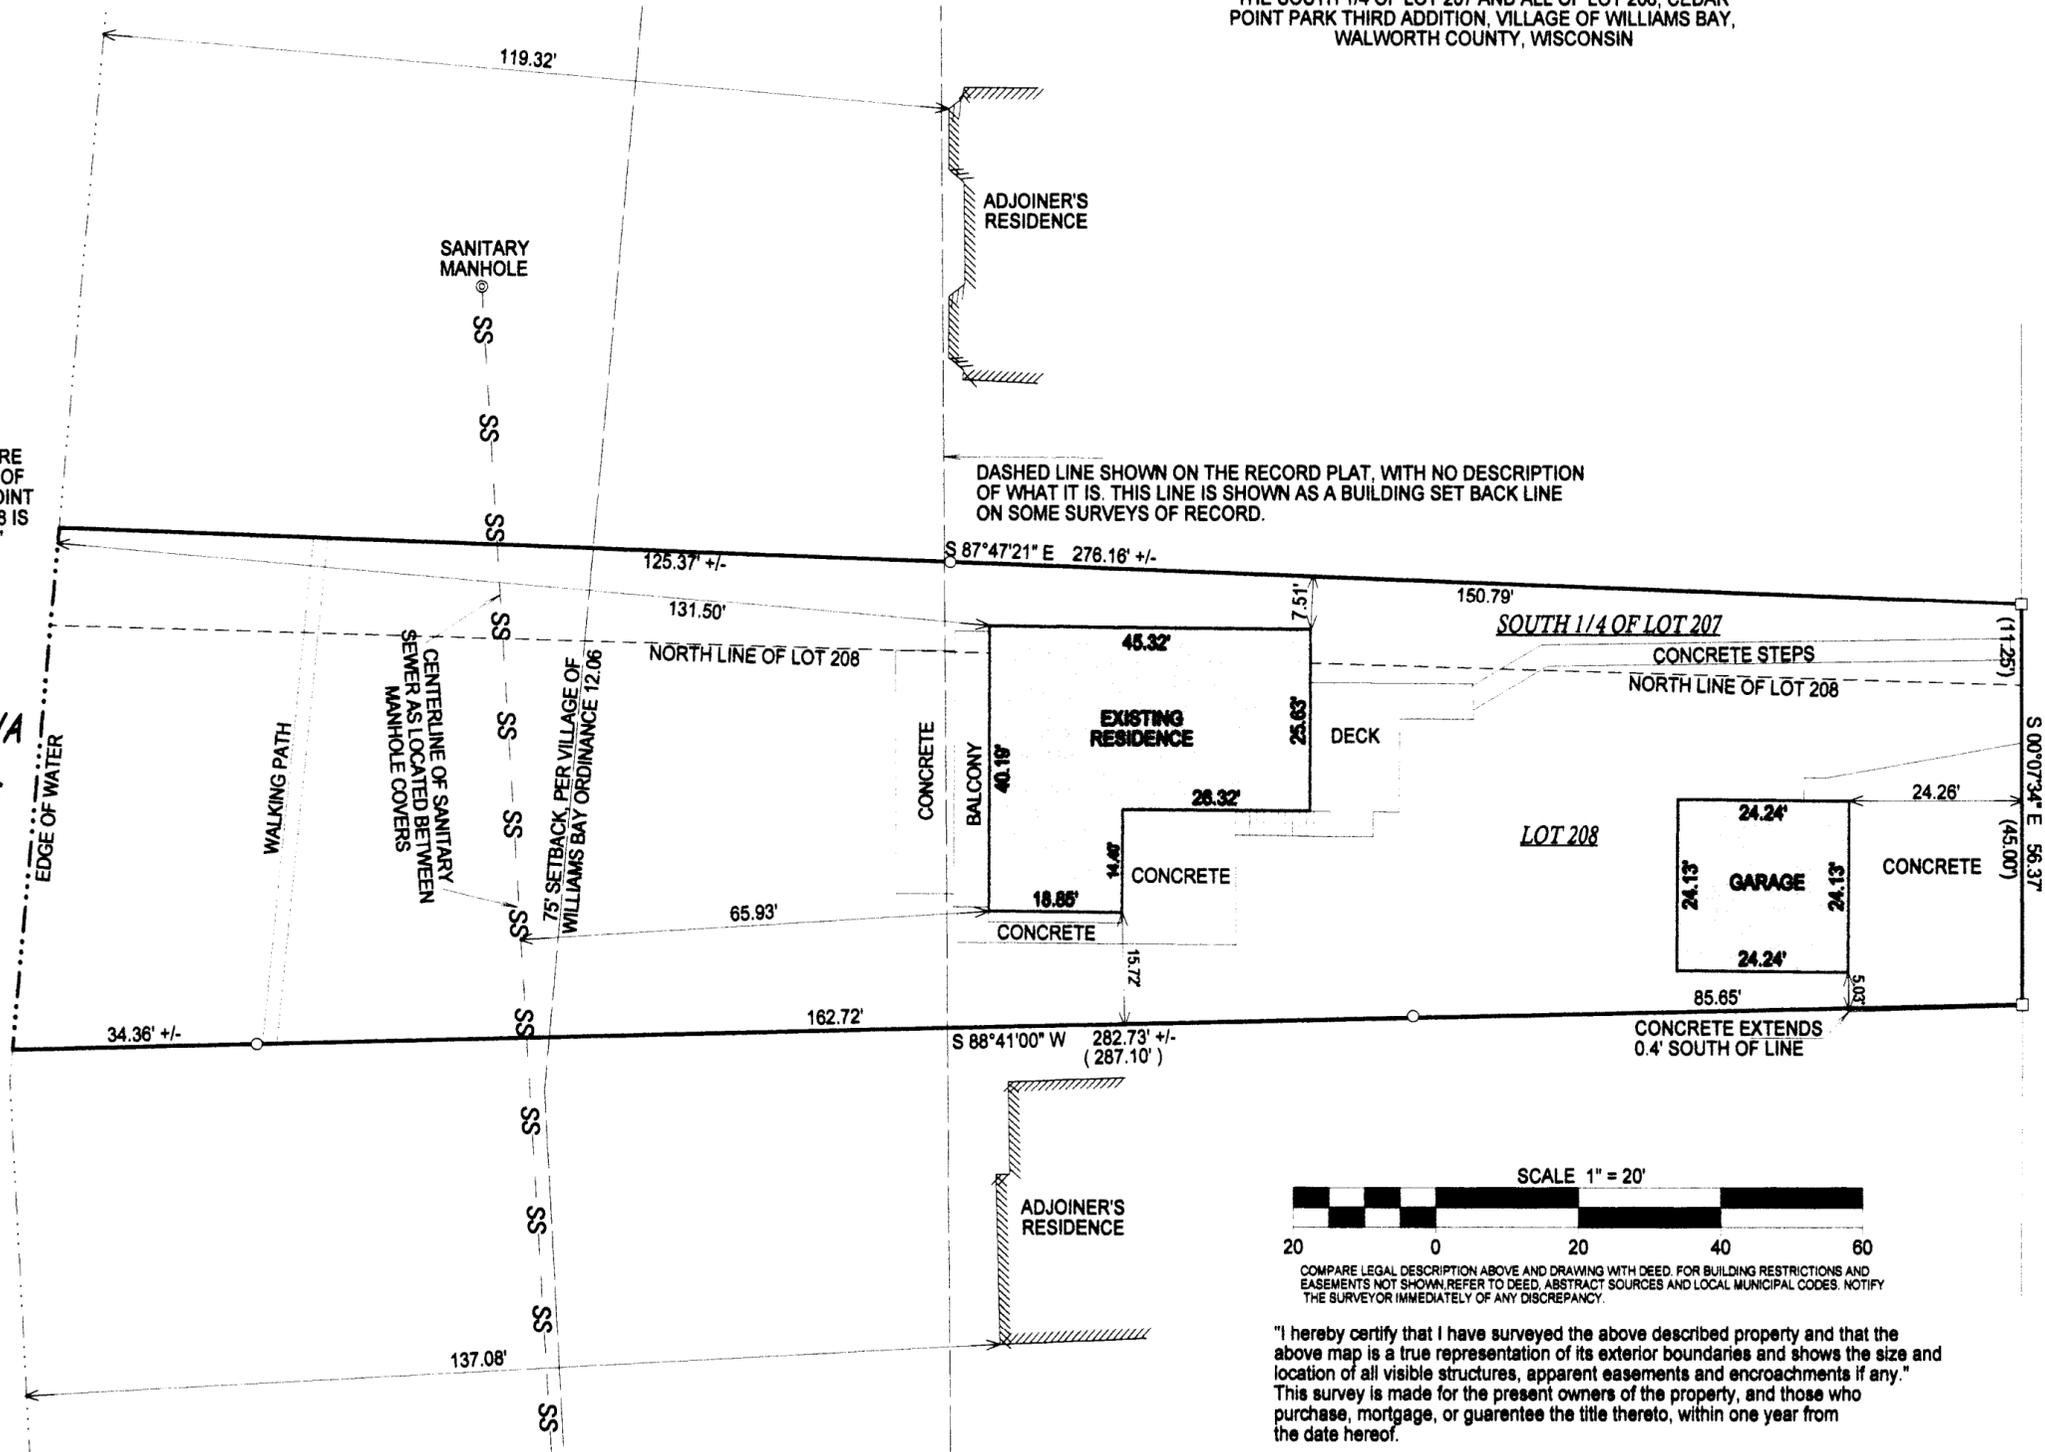


DEC 10 2010

*JK*

- ( ) = recorded as
- = found iron bar
- = found iron pipe
- = set iron pipe
- = set iron bar

JOB # 10-171

TAX ID # WCP3 00007

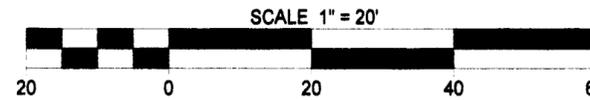

COMPARE LEGAL DESCRIPTION ABOVE AND DRAWING WITH DEED. FOR BUILDING RESTRICTIONS AND EASEMENTS NOT SHOWN REFER TO DEED, ABSTRACT SOURCES AND LOCAL MUNICIPAL CODES. NOTIFY THE SURVEYOR IMMEDIATELY OF ANY DISCREPANCY.

"I hereby certify that I have surveyed the above described property and that the above map is a true representation of its exterior boundaries and shows the size and location of all visible structures, apparent easements and encroachments if any." This survey is made for the present owners of the property, and those who purchase, mortgage, or guarantee the title thereto, within one year from the date hereof.

DATED THIS 30th DAY OF NOVEMBER, 2010.

CIRCLE PARKWAY  
(40' WIDE)



*Jeffrey L. Kimps*  
JEFFREY L. KIMPS S-2436  
Wisconsin Registered Land Surveyor  
(original if signed in red)

011-2342