

PREPARED FOR:
DOROTHY GERBER
SHOREWEST REALTORS
623 MAIN STREET
LAKE GENEVA, WI 53147

PLAT OF SURVEY

-OF-

LOT 56 WILLABAY WOODS, A SUBDIVISION LOCATED IN THE
VILLAGE OF WILLIAMS BAY, WALWORTH COUNTY, WISCONSIN.


KROTT SURVEYING INC.

N3705 WILLOW BEND LANE
LAKE GENEVA WI. 53147
PHONE # (262)248-3697
FAX # (262)249-0639



LEGEND


- E— OVER HEAD UTILITIES
- ▣ UTILITY PEDESALS
- ▢ TRANSFORMER
- ⊙ FOUND 2" DIA. IRON PIPE
- ⊘ UTILITY POLE
- FOUND IRON PIPE
- FOUND IRON BAR
- SET IRON BAR
- (XX) RECORDED AS

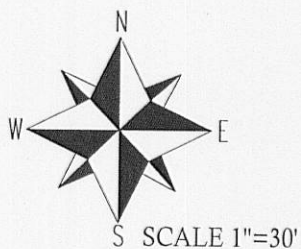

BEARINGS REFERENCED TO THE RECORD PLAT
OF WILLABAY WOODS

I have surveyed the above-described property and the above map is a true representation thereof and shows the size and location of the property, its exterior boundaries, the location and dimensions of all structures thereon, fences apparent easements and roadways and visible encroachments, if any.

This survey is made for the exclusive use of the present owners of the property, and also those who purchase, mortgage, or insure the title thereto within one (1) year from date hereof; and as to them I warrant the accuracy of said survey map.

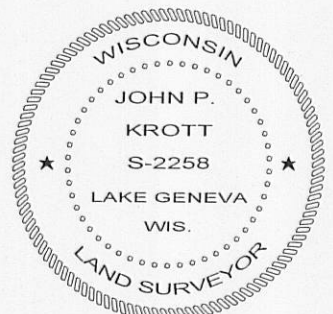

DATED THIS 13th, DAY OF APRIL, 2011

John P. Krott

JOHN KROTT S - 2258
Wisconsin Registered Land Surveyor
(original if signed in red)

JOB # 11-050 TAX ID # WUW00056