PREPARED FOR LINDA TONGE KEEFE REAL ESTATE, INC. 751 GENEVA PARKWAY LAKE GENEVA, WI 53147


PLAT OF SURVEY

-OF-

LOT 3, EXCEPT THE NORTH 10 FEET THEREOF AND THE WEST 37 FEET OF LOT 2, EXCEPT THE NORTH 10 FEET THEREOF, IN MADISON'S ADDITION TO WILLIAMS BAY, BEING A PART OF THE NORTHEAST 1/4 OF SECTION 1, IN TOWNSHIP 1 NORTH, RANGE 16 EAST, IN THE VILLAGE OF WILLIAMS BAY, WALWORTH COUNTY, WISCONSIN.

KROTT SURVEYING INC.

N3705 WILLOW BEND LANE LAKE GENEVA WI. 53147 PHONE # (262)248-3697 FAX # (262)249-0639

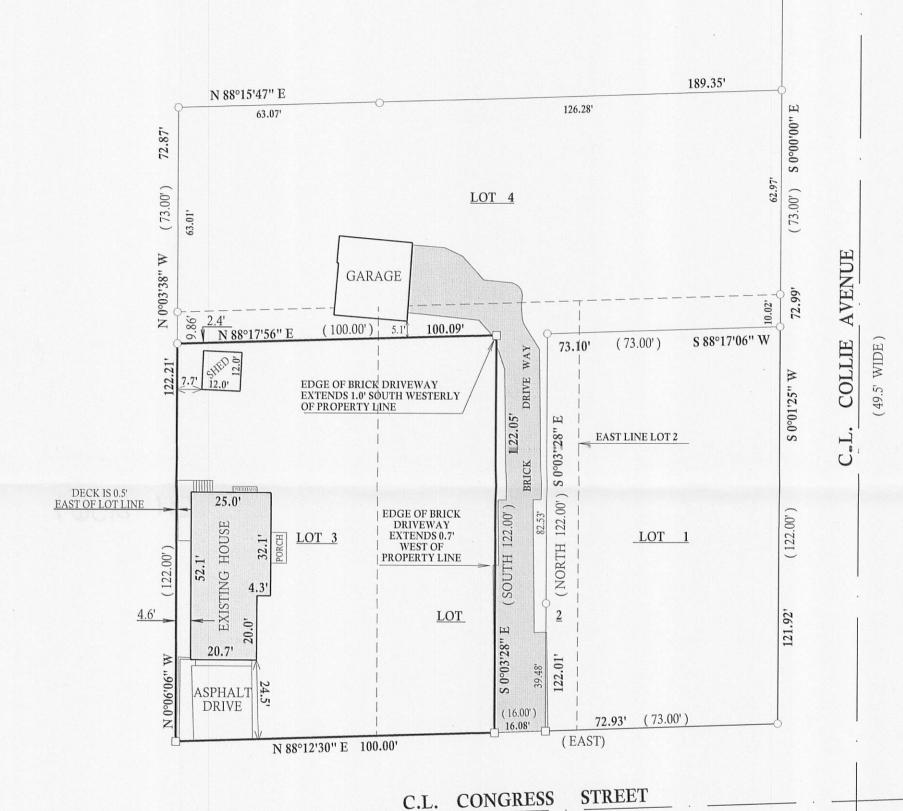



DEGETUE JUL - 6 2011 By

LEGEND

- O FOUND IRON PIPE
- ☐ FOUND IRON BAR

(XX) RECORDED AS TAX ID # WMA00003 JOB #11-071

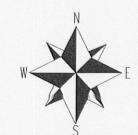

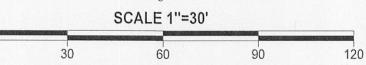

(49.5' WIDE)

I have surveyed the above-described property and the above map is a true representation thereof and shows the size and location of the property, its exterior boundaries, the location and dimensions of all structures thereon, fences apparent easements and roadways and visible encroachments. if any.

This survey is made for the exclusive use of the present owners of the property, and also those who puchase, mortgage, or insure the title therto within one (1) year from date hereof; and as to them I warrant the accuracy of said survey map.

NOTE : BEARINGS ARE REFRENCED TO PREVIOUS SURVEYS OF RECORD



DATED THIS 17th, DAY OF MAY, 2011

JOHN KROTT S - 2258 Wisconsin Registered Land Surveyor (original if signed in red)

011-2367