

# PLAT OF SURVEY


-OF-

KROTT SURVEYING INC.


N3705 WILLOW BEND LANE  
LAKE GENEVA WI. 53147  
PHONE # (262)248-3697  
FAX # (262)249-0639




- (XX) RECORDED AS  
TAX ID # WL2 00002  
JOB # 09-090AB

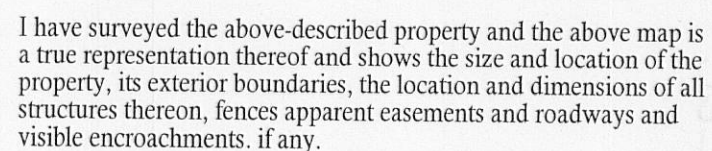


This survey is made for the exclusive use of the present owners of the property, and also those who purchase, mortgage, or insure the title thereto within one (1) year from date hereof; and as to them I warrant the accuracy of said survey map.

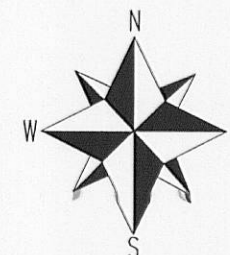

SCALE 1"=20'

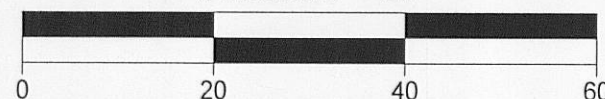

BEARINGS REFERENCED TO THE  
RECORD PLAT OF LOCH VISTA CLUB  
SUBDIVISION NO. 3

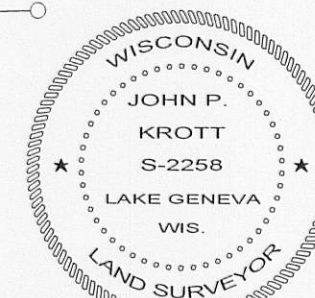

DATED THIS 17th, DAY OF JULY, 2009  
DATE OF LAST REVISION 06 / 02 / 2011.  
REVISED 12 / 06 / 2010.

  
JOHN KROTT S - 2258  
Wisconsin Registered Land Surveyor  
( original if signed in red )

011-2370